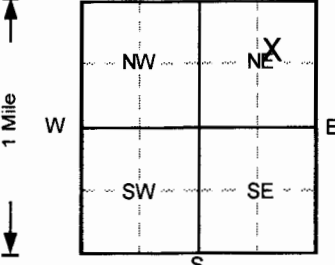


WATER WELL RECORD Form WWC-5 KSA 82a-1212

1 LOCATION OF WATER WELL:	Fraction	Section Number	Township Number	Range Number
County: Sedgwick	SW ¼ NE ¼ NE ¼	16	T 25 S	R 2 (E/W)
Distance and direction from nearest town or city street address of well if located within city? N. Avenue D & 4th St., Furley				
2 WATER WELL OWNER: Epp's Service, Inc.				
RR#, St. Address, Box # : PO Box 40		Board of Agriculture, Division of Water Resources		
City, State, ZIP Code : Elbing, Kansas 67041		Application Number:		
3 LOCATE WELL'S LOCATION WITH AN "X" IN SECTION BOX: 	4 DEPTH OF COMPLETED WELL 25 ft. ELEVATION: 1411.31			
	Depth(s) Groundwater Encountered 1..... ft. 2..... ft. 3..... ft.			
	WELL'S STATIC WATER LEVEL ft. below land surface measured on mo/day/yr			
	Pump test data: Well water was NA ft. after hours pumping gpm Est. Yield NA gpm: Well water was ft. after hours pumping gpm Bore Hole Diameter 8 in. to 25 ft., and in. to ft. WELL WATER TO BE USED AS: 5 Public water supply 8 Air conditioning 11 Injection well 1 Domestic 3 Feedlot 6 Oil field water supply 9 Dewatering 12 Other (Specify below) 2 Irrigation 4 Industrial 7 Lawn and garden only 10 Monitoring well Was a chemical/bacteriological sample submitted to Department? Yes.....No <input checked="" type="checkbox"/> ; If yes, mo/day/yr sample was submitted Water Well Disinfected? Yes No <input checked="" type="checkbox"/>			
5 TYPE OF BLANK CASING USED:				
1 Steel		3 RMP (SR)	5 Wrought iron	8 Concrete tile
2 PVC	4 ABS	7 Fiberglass	CASING JOINTS: Glued Clamped	
Blank casing diameter 2 in. to 10 ft., Dia in. to ft., Dia in. to ft.		Welded		
Casing height above land surface -3.12 in., weight lbs./ft. Wall thickness or gauge No. Sch. 40		Threaded. <input checked="" type="checkbox"/>		
TYPE OF SCREEN OR PERFORATION MATERIAL				
1 Steel	3 Stainless steel	5 Fiberglass	7 PVC	10 Asbestos-cement
2 Brass	4 Galvanized steel	6 Concrete tile	8 RMP (SR)	11 Other (specify)
SCREEN OR PERFORATION OPENINGS ARE:				
1 Continuous slot	3 Mill slot	6 Wire wrapped	8 Saw cut	11 None (open hole)
2 Louvered shutter	4 Key punched	7 Torch cut	9 Drilled holes	12 None used (open hole)
SCREEN-PERFORATED INTERVALS: From 10 ft. to 25 ft., From ft. to ft.				
GRAVEL PACK INTERVALS: From 8 ft. to 25 ft., From ft. to ft.				
From ft. to ft., From ft. to ft.				
6 GROUT MATERIAL: 1 Neat cement 2 Cement grout 3 Bentonite 4 Other Concrete				
Grout Intervals: From 0 ft. to 1 ft., From 1 ft. to 8 ft., From ft. to ft.				
What is the nearest source of possible contamination:				
1 Septic tank	4 Lateral lines	7 Pit privy	10 Livestock pens	14 Abandoned water well
2 Sewer lines	5 Cess pool	8 Sewage lagoon	11 Fuel storage	15 Oil well/Gas well
3 Watertight sewer lines	6 Seepage pit	9 Feedyard	12 Fertilizer storage	16 Other (specify below)
Direction from well?	How many feet?			
FROM		TO	LITHOLOGIC LOG	
FROM		TO	PLUGGING INTERVALS	
0	3	Clay, silty, moist, no odor, Dark Brown		
3	6	Clay, sl. silty, moist, no odor, Brown		
6	20	Shale, sl. weathered, Yellow Brown		
20	25	Shale, v. weathered, saturated, Yellow		
MW8 , Tag # 0041438 , Flushmount				
Project Name: Epp's Service, Inc.				
GeoCore # 1213 , KDHE # U2 087 12573				
7 CONTRACTOR'S OR LANDOWNER'S CERTIFICATION: This water well was (1) constructed, (2) reconstructed, or (3) plugged under my jurisdiction and was completed on (mo/day/year) 6/4/2008 and this record is true to the best of my knowledge and belief. Kansas Water Well Contractor's License No. 527 This Water Well Record was completed on (mo/day/yr) 6/23/2008 under the business name of GeoCore, Inc. by (signature) <i>Dale Bell</i>				
INSTRUCTIONS: Use typewriter or ball point pen. PLEASE PRESS FIRMLY and PRINT clearly. Please fill in blanks, underline or circle the correct answers. Send top three copies to Kansas Department of Health and Environment, Bureau of Water, Topeka, Kansas 66620-0001. Telephone: 913-296-5545. Send one to WATER WELL OWNER and retain one for your records.				

OFFICE USE ONLY T R E/W SEC. 1/4 1/4