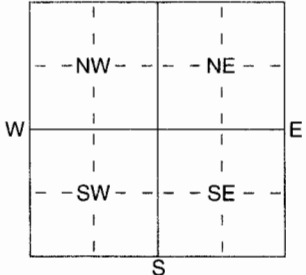


1 LOCATION OF WATER WELL: Fraction SW 1/4 NE 1/4 SW 1/4 Section Number 26 Township Number T 25 S Range Number R 02 EW
 County: Sedgwick

Distance and direction from nearest town or city street address of well if located within city?
Approximately 3 miles SE of Furley KS

2 WATER WELL OWNER: NIES
 RR#, St. Address, Box #: 8808 North 127th St East Board of Agriculture, Division of Water Resources
 City, State, ZIP Code: Valley Center KS 67147 Application Number:

3 LOCATE WELL'S LOCATION WITH AN "X" IN SECTION BOX:  4 DEPTH OF COMPLETED WELL 57.8 ft. ELEVATION: _____ ft.
 Depth(s) Groundwater Encountered 1 _____ ft. 2 _____ ft. 3 _____ ft.
 WELL'S STATIC WATER LEVEL 40.5 ft. below land surface measured on mo/day/yr _____
 Pump test data: Well water was _____ ft. after _____ hours pumping _____ gpm
 Est. Yield _____ gpm: Well water was _____ ft. after _____ hours pumping _____ gpm
 WELL WATER TO BE USED AS: 5 Public water supply 8 Air conditioning 11 Injection well
 1 Domestic 3 Feedlot 6 Oil field water supply 9 Dewatering 12 Other (Specify below)
 2 Irrigation 4 Industrial 7 Domestic (lawn & garden) 10 Monitoring well _____
 Was a chemical/bacteriological sample submitted to Department? Yes _____ No X _____; If yes, mo/day/yr sample was sub-
 mitted Water Well Disinfected? Yes _____ No X _____

5 TYPE OF BLANK CASING USED: 1 Steel 3 RMP (SR) 5 Wrought iron 8 Concrete tile CASING JOINTS: Glued _____ Clamped _____
 2 PVC 4 ABS 6 Asbestos-Cement 9 Other (specify below) Welded
 7 Fiberglass _____ Threaded _____
 Blank casing diameter 30 in. to 38.1 ft., Dia 12 in. to 44.6 ft., Dia _____ in. to _____ ft.
 Casing height above land surface 2.2 ft weight _____ lbs./ft. Wall thickness or gauge No. _____
 TYPE OF SCREEN OR PERFORATION MATERIAL: 1 Steel 3 Stainless Steel 5 Fiberglass 7 PVC 10 Asbestos-Cement
 2 Brass 4 Galvanized Steel 6 Concrete tile 8 RMP (SR) 11 Other (Specify) _____
 9 ABS 12 None used (open hole)
 SCREEN OR PERFORATION OPENINGS ARE: 0.060 in. 5 Gauzed wrapped 8 Saw cut 11 None (open hole)
 1 Continuous slot 3 Mill slot 6 Wire wrapped 9 Drilled holes
 2 Louvered shutter 4 Key punched 7 Torch cut 10 Other (specify) _____ ft.
 SCREEN-PERFORATED INTERVALS: From 44.6 ft. to 54.6 ft., From _____ ft. to _____ ft.
 GRAVEL PACK INTERVALS: From 39.8 ft. to 57.8 ft., From _____ ft. to _____ ft.
 From _____ ft. to _____ ft., From _____ ft. to _____ ft.

6 GROUT MATERIAL: 1 Neat cement 2 Cement grout 3 Bentonite 4 Other _____
 Grout Intervals: From 56 ft. to 3 ft., From _____ ft. to _____ ft., From _____ ft. to _____ ft.
 What is the nearest source of possible contamination: 10 Livestock pens 14 Abandoned water well
 1 Septic tank 4 Lateral lines 7 Pit privy 11 Fuel storage 15 Oil well/Gas well
 2 Sewer lines 5 Cess pool 8 Sewage lagoon 12 Fertilizer storage 16 Other (specify below)
 3 Watertight sewer lines 6 Seepage pit 9 Feedyard 13 Insecticide storage haz Waste Facility
 Direction from well? North How many feet? Approx. 145

FROM	TO	LITHOLOGIC LOG	FROM	TO	PLUGGING INTERVALS
		<u>Well Abandoned 8/1/08</u>	<u>56</u>	<u>3</u>	<u>Bentonite grout pumped from bottom to top.</u>
		<u>Removed cover, cut off casing and removed 3 ft below surface.</u>	<u>3</u>	<u>Ø</u>	<u>Soils</u>

7 CONTRACTOR'S OR LANDOWNER'S CERTIFICATION: This water well was (1) constructed, (2) reconstructed, or (3) plugged under my jurisdiction and was completed on (mo/day/year) 8/1/08 and this record is true to the best of my knowledge and belief. Kansas Water Well Contractor's Licence No. 570 This Water Well Record was completed on (mo/day/yr) 8/12/08 under the business name of Aquadrill Inc. by (signature) Map Richardson