


1 LOCATION OF WATER WELL:	Fraction	Section Number	Township Number	Range Number
County: Sedgwick	SE 1/4 NE 1/4 SW 1/4	26	T 25 S	R 2 E/W

Distance and direction from nearest town or city street address of well if located within city?

8808 N. 127th St. E, Valley Center

2 WATER WELL OWNER: Chemical Waste Management, Inc. RR#, St. Address, Box # : 8808 N. 127th East City, State, ZIP Code : Valley Center, KS 67147	Board of Agriculture, Division of Water Resources Application Number:
--	--

3 LOCATE WELL'S LOCATION WITH AN "X" IN SECTION BOX:

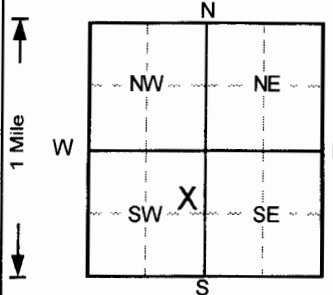

4 DEPTH OF COMPLETED WELL 46 ft	ELEVATION: 1378.631
Depth(s) Groundwater Encountered 1. ft 2. ft 3. ft	
WELL'S STATIC WATER LEVEL . . . 43.84 . . . ft. below land surface measured on mo/day/yr . . . 1/28/2010 . . .	
Pump test data: Well water was . . . NA . . . ft. after hours pumping gpm	
Est. Yield . . . NA . . . gpm: Well water was ft. after hours pumping gpm	
Bore Hole Diameter . . . 13 . . . in. to . . . 38 . . . ft., and . . . 8 . . . in. to . . . 46 . . . ft.	
WELL WATER TO BE USED AS:	5 Public water supply 8 Air conditioning 11 Injection well
1 Domestic 3 Feedlot 6 Oil field water supply 9 Dewatering 12 Other (Specify below)	
2 Irrigation 4 Industrial 7 Lawn and garden only 10 Monitoring well	
Was a chemical/bacteriological sample submitted to Department? Yes.....No <input checked="" type="checkbox"/> ; If yes, mo/day/yr sample was submitted	Water Well Disinfected? Yes No <input checked="" type="checkbox"/>

5 TYPE OF BLANK CASING USED:	5 Wrought iron 8 Concrete tile	CASING JOINTS: Glued Clamped
1 Steel 3 RMP (SR)	6 Asbestos-Cement 9 Other (specify below)	Welded
2 PVC 4 ABS	7 Fiberglass	Threaded. <input checked="" type="checkbox"/>
Blank casing diameter 10 in. to 38 ft., Dia 2 in. to 41 ft., Dia in. to ft.		
Casing height above land surface 31.8 in., weight lbs./ft. Wall thickness or gauge No. Sch. 40		
TYPE OF SCREEN OR PERFORATION MATERIAL	7 PVC 10 Asbestos-cement	
1 Steel 3 Stainless steel 5 Fiberglass 8 RMP (SR)	11 Other (specify)	
2 Brass 4 Galvanized steel 6 Concrete tile 9 ABS	12 None used (open hole)	
SCREEN OR PERFORATION OPENINGS ARE:	5 Gauzed wrapped 8 Saw cut 11 None (open hole)	
1 Continuous slot 3 Mill slot 6 Wire wrapped 9 Drilled holes		
2 Louvered shutter 4 Key punched 7 Torch cut 10 Other (specify)		
SCREEN-PERFORATED INTERVALS: From 41 ft. to 46 ft., From ft. to ft.		
GRAVEL PACK INTERVALS: From 39 ft. to 46 ft., From ft. to ft.		

6 GROUT MATERIAL:	1 Neat cement 2 Cement grout 3 Bentonite 4 Other	Grout Intervals: From 0 ft. to 37 ft., From 37 ft. to 39 ft., From ft. to ft.
What is the nearest source of possible contamination:	10 Livestock pens 14 Abandoned water well	
1 Septic tank 4 Lateral lines 7 Pit privy 11 Fuel storage 15 Oil well/Gas well		
2 Sewer lines 5 Cess pool 8 Sewage lagoon 12 Fertilizer storage 16 Other (specify below)		
3 Watertight sewer lines 6 Seepage pit 9 Feedyard 13 Insecticide storage		
Direction from well?	How many feet?	

FROM	TO	LITHOLOGIC LOG	FROM	TO	PLUGGING INTERVALS
0	5	Clay fill layers			
5	7	Clay topsoil fill			
7	8	Clay fill			
8	12	Clay			
12	13.5	Clay, calcite veins			
13.5	17.5	Shale, weathered			
17.5	20	Clay			
20	22.5	Shale, weathered			
22.5	23.5	Clay, calcite nodules			
23.5	25	Clay, calcite veins and nodules			
25	38	Shale and clay,			
38	42	Clay,			
42	46	Shale			BP02 , Abovegrade

7 CONTRACTOR'S OR LANDOWNER'S CERTIFICATION: This water well was (1) constructed, (2) reconstructed, or (3) plugged under my jurisdiction and was completed on (mo/day/year) 1/26/2010 and this record is true to the best of my knowledge and belief.	
Kansas Water Well Contractor's License No. 527 This Water Well Record was completed on (mo/day/yr) 2/19/20	
under the business name of GeoCore, Inc. by (signature) <i>Don Hall</i>	

INSTRUCTIONS: Use typewriter or ball point pen. PLEASE PRESS FIRMLY and PRINT clearly. Please fill in blanks, underline or circle the correct answers. Send top three copies to Kansas Department of Health and Environment, Bureau of Water, Topeka, Kansas 66620-0001. Telephone: 913-296-5545. Send one to WATER WELL OWNER and retain one for your records.

OFFICE USE ONLY
T
R
EM
SEC