


1 LOCATION OF WATER WELL: County: **Sedgwick** Fraction: **SW 1/4 NE 1/4 SW 1/4** Section Number: **26** Township Number: **T 25 S** Range Number: **R 2** **(E/W)**

Distance and direction from nearest town or city street address of well if located within city?  
**8808 N. 127th St. E, Valley Center**

2 WATER WELL OWNER: **Chemical Waste Management, Inc.**  
 RR#, St. Address, Box #: **8808 N. 127th East**  
 City, State, ZIP Code: **Valley Center, KS 67147**  
 Board of Agriculture, Division of Water Resources  
 Application Number:

3 LOCATE WELL'S LOCATION WITH AN "X" IN SECTION BOX:

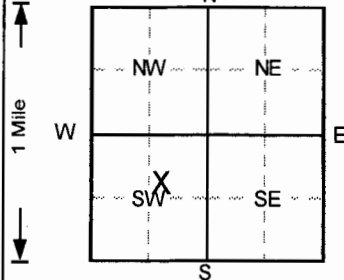

4 DEPTH OF COMPLETED WELL: **57** ft. ELEVATION: **1382.445**  
 Depth(s) Groundwater Encountered: 1. .... ft. 2. .... ft. 3. .... ft.  
 WELL'S STATIC WATER LEVEL: **47.71** ft. below land surface measured on mo/day/yr: **1/28/2010**  
 Pump test data: Well water was **NA** ft. after ..... hours pumping ..... gpm  
 Est. Yield: **NA** gpm; Well water was ..... ft. after ..... hours pumping ..... gpm  
 Bore Hole Diameter: **13** in. to **37** ft., and **8** in. to **57** ft.  
 WELL WATER TO BE USED AS:  
 5 Public water supply 8 Air conditioning 11 Injection well  
 1 Domestic 3 Feedlot 6 Oil field water supply 9 Dewatering 12 Other (Specify below)  
 2 Irrigation 4 Industrial 7 Lawn and garden only **10** Monitoring well  
 Was a chemical/bacteriological sample submitted to Department? Yes.....No  ; If yes, mo/day/yr sample was submitted  
 Water Well Disinfected? Yes No

5 TYPE OF BLANK CASING USED:  
 1 Steel 3 RMP (SR) 5 Wrought iron 8 Concrete tile CASING JOINTS: Glued ..... Clamped .....  
**2** PVC 4 ABS 6 Asbestos-Cement 9 Other (specify below) Welded .....  
 7 Fiberglass Threaded.   
 Blank casing diameter: **10** in. to **37** ft., Dia: **2** in. to **52** ft., Dia: ..... in. to ..... ft.  
 Casing height above land surface: **33.24** in., weight: ..... lbs./ft. Wall thickness or gauge No. ....  
 TYPE OF SCREEN OR PERFORATION MATERIAL:  
 1 Steel 3 Stainless steel 5 Fiberglass **7** PVC 10 Asbestos-cement  
 2 Brass 4 Galvanized steel 6 Concrete tile 8 RMP (SR) 11 Other (specify) .....  
 12 None used (open hole)  
 SCREEN OR PERFORATION OPENINGS ARE:  
 1 Continuous slot **3** Mill slot 5 Gauzed wrapped 8 Saw cut 11 None (open hole)  
 2 Louvered shutter 4 Key punched 6 Wire wrapped 9 Drilled holes  
 7 Torch cut 10 Other (specify) .....  
 SCREEN-PERFORATED INTERVALS: From **52** ft. to **57** ft., From ..... ft. to ..... ft.  
 From ..... ft. to ..... ft., From ..... ft. to ..... ft.  
 GRAVEL PACK INTERVALS: From **50** ft. to **57** ft., From ..... ft. to ..... ft.  
 From ..... ft. to ..... ft., From ..... ft. to ..... ft.

6 GROUT MATERIAL: 1 Neat cement **2** Cement grout **3** Bentonite 4 Other .....  
 Grout Intervals: From **0** ft. to **48** ft., From **48** ft. to **50** ft., From ..... ft. to ..... ft.  
 What is the nearest source of possible contamination:  
 1 Septic tank 4 Lateral lines 7 Pit privy 10 Livestock pens 14 Abandoned water well  
 2 Sewer lines 5 Cess pool 8 Sewage lagoon 11 Fuel storage 15 Oil well/Gas well  
 3 Watertight sewer lines 6 Seepage pit 9 Feedyard 12 Fertilizer storage 16 Other (specify below)  
 13 Insecticide storage .....  
 Direction from well? How many feet?

FROM	TO	LITHOLOGIC LOG	FROM	TO	PLUGGING INTERVALS
0	3	Clay, w/caliche and road gravel,	50	50.5	Clay,
3	10	Clay fill w/clay streaks,	51.75	57	Shale, weathered
10	12	Clay topsoil fill,	57	57	Limestone
12	17.5	Clay fill w/caliche streaks,			
17.5	17.5	Sand streak (fill),			
17.5	20	Clay w/caliche streaks and veins			
20	25	Shale, weathered,			
25	26.7	Clay w/caliche streaks			
26.7	29.5	Shale w/calcite veins,			
29.5	35	Clay w/boxwork calcite,			
35	40	Clay			
40	45	Shale, weathered			
45	48	Gypsum, alabaster, w/clay,			B413, Abovegrade
48	49.5	Clay			
49.5	50	Shale, weathered			

7 CONTRACTOR'S OR LANDOWNER'S CERTIFICATION: This water well was **(1)** constructed, (2) reconstructed, or (3) plugged under my jurisdiction and was completed on (mo/day/year) **1/26/2010** and this record is true to the best of my knowledge and belief.  
 Kansas Water Well Contractor's License No. **527** This Water Well Record was completed on (mo/day/yr) **2/19/2010**  
 under the business name of **GeoCore, Inc.** by (signature) *[Signature]*