

WATER WELL RECORD Form WWC-5 KSA 82a-1212


1 LOCATION OF WATER WELL:	Fraction	Section Number	Township Number	Range Number
County: Sedgwick	SE 1/4 NW 1/4 SW 1/4	26	T 25 S	R 2 E/W

Distance and direction from nearest town or city street address of well if located within city?

8808 N. 127th St. E, Valley Center

2 WATER WELL OWNER: **Chemical Waste Management, Inc.**
 RR#, St. Address, Box # : **8808 N. 127th East**
 City, State, ZIP Code : **Valley Center, KS 67147**
 Board of Agriculture, Division of Water Resources
 Application Number:

3 LOCATE WELL'S LOCATION WITH AN "X" IN SECTION BOX:

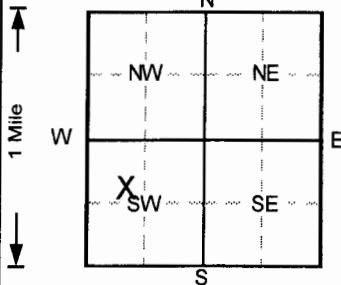

4 DEPTH OF COMPLETED WELL: **65** ft. ELEVATION: **1388.499**
 Depth(s) Groundwater Encountered 1. ft. 2. ft. 3. ft.
 WELL'S STATIC WATER LEVEL: **54.8** ft. below land surface measured on mo/day/yr **1/28/2010**
 Pump test data: Well water was **NA** ft. after hours pumping gpm
 Est. Yield **NA** gpm: Well water was ft. after hours pumping gpm
 Bore Hole Diameter: **13** in. to **42** ft., and **8** in. to **65** ft.
 WELL WATER TO BE USED AS:
 5 Public water supply 8 Air conditioning 11 Injection well
 1 Domestic 3 Feedlot 6 Oil field water supply 9 Dewatering 12 Other (Specify below)
 2 Irrigation 4 Industrial 7 Lawn and garden only **10 Monitoring well**
 Was a chemical/bacteriological sample submitted to Department? Yes. No
 Water Well Disinfected? Yes No

5 TYPE OF BLANK CASING USED:
 1 Steel 3 RMP (SR) 5 Wrought iron 8 Concrete tile CASING JOINTS: Glued Clamped
2 PVC 4 ABS 6 Asbestos-Cement 9 Other (specify below) Welded
 7 Fiberglass Threaded.
 Blank casing diameter: **10** in. to **42** ft., Dia. **2** in. to **65** ft., Dia. in. to ft.
 Casing height above land surface: **33.84** in., weight lbs./ft. Wall thickness or gauge No. **Sch. 40**
 TYPE OF SCREEN OR PERFORATION MATERIAL
 1 Steel 3 Stainless steel 5 Fiberglass **7 PVC** 10 Asbestos-cement
 2 Brass 4 Galvanized steel 6 Concrete tile 8 RMP (SR) 11 Other (specify)
 12 None used (open hole)
 SCREEN OR PERFORATION OPENINGS ARE:
 1 Continuous slot **3 Mill slot** 5 Gauzed wrapped 8 Saw cut 11 None (open hole)
 2 Louvered shutter 4 Key punched 6 Wire wrapped 9 Drilled holes
 7 Torch cut 10 Other (specify)
 SCREEN-PERFORATED INTERVALS: From **60** ft. to **65** ft., From ft. to ft.
 From ft. to ft., From ft. to ft.
 GRAVEL PACK INTERVALS: From **58** ft. to **65** ft., From ft. to ft.
 From ft. to ft., From ft. to ft.

6 GROUT MATERIAL: 1 Neat cement **2 Cement grout** **3 Bentonite** 4 Other
 Grout Intervals: From **0** ft. to **56** ft., From **56** ft. to **58** ft., From ft. to ft.
 What is the nearest source of possible contamination:
 1 Septic tank 4 Lateral lines 7 Pit privy 10 Livestock pens 14 Abandoned water well
 2 Sewer lines 5 Cess pool 8 Sewage lagoon 11 Fuel storage 15 Oil well/Gas well
 3 Watertight sewer lines 6 Seepage pit 9 Feedyard 12 Fertilizer storage 16 Other (specify below)
 Direction from well? How many feet?

FROM	TO	LITHOLOGIC LOG	FROM	TO	PLUGGING INTERVALS
0	0.2	Topsoil, roots,	43.5	45.5	Clay changing to limey shale
0.2	0.6	Sand, gravel, clay road bed,	45.5	46.5	Clay
0.6	13.8	Clay,	46.5	46.75	Sand, fine grained,
13.8	15	Clay w/clay streaks	46.75	48	Clay w/silt and f sand
15	16.5	As above, w/caliche streaks,	48	48.25	Sands, frac., cemented,
16.5	22.3	Clay	48.25	52	Clay,
22.3	23.7	Shale, weathered	52	52.25	Mudstone,
23.7	26.4	Clay	52.25	59.5	Clay,
26.4	27.5	Clay, calcite nodules caliche streaks	59.5	65	Shale,
27.5	29.5	Clay, calcite veins			
29.5	30.5	Clay lenses			
30.5	36.5	Clay			
36.5	39	Shale			BP03, Abovegrade
39	43	Clay,			
43	43.5	Clay w/caliche veins			

7 CONTRACTOR'S OR LANDOWNER'S CERTIFICATION: This water well was **(1)** constructed, (2) reconstructed, or (3) plugged under my jurisdiction and was completed on (mo/day/year) **1/26/2010** and this record is true to the best of my knowledge and belief.
 Kansas Water Well Contractor's License No. **527** This Water Well Record was completed on (mo/day/yr) **2/19/2010**
 under the business name of **GeoCore, Inc.** by (signature) *[Signature]*

INSTRUCTIONS: Use typewriter or ball point pen. PLEASE PRESS FIRMLY and PRINT clearly. Please fill in blanks, underline or circle the correct answers. Send top three copies to Kansas Department of Health and Environment, Bureau of Water, Topeka, Kansas 66620-0001. Telephone: 913-296-5545. Send one to WATER WELL OWNER and retain one for your records.

OFFICE USE ONLY
T
R
EW
SEC
1/4
1/4