


1 LOCATION OF WATER WELL: County: Sedgwick	Fraction SW 1/4 NW 1/4 SW 1/4	Section Number 26	Township Number T 25 S	Range Number R 2 E/W
--	---	-----------------------------	----------------------------------	--------------------------------

Distance and direction from nearest town or city street address of well if located within city?

8808 N. 127th St. E, Valley Center

2 WATER WELL OWNER: Chemical Waste Management, Inc. RR#, St. Address, Box # 8808 N. 127th East City, State, ZIP Code Valley Center, KS 67147	Board of Agriculture, Division of Water Resources Application Number:
--	--

3 LOCATE WELL'S LOCATION WITH AN "X" IN SECTION BOX:

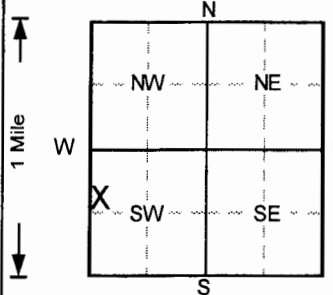

4 DEPTH OF COMPLETED WELL **71** ft. ELEVATION: **1385.763**

Depth(s) Groundwater Encountered 1. ft. 2. ft. 3. ft.

WELL'S STATIC WATER LEVEL **47.54** ft. below land surface measured on mo/day/yr **1/28/2010**

Pump test data: Well water was **NA** ft. after hours pumping gpm

Est. Yield **NA** gpm: Well water was ft. after hours pumping gpm

Bore Hole Diameter **13** in. to **44** ft., and **8** in. to **74** ft.

WELL WATER TO BE USED AS:

5 Public water supply	8 Air conditioning	11 Injection well
1 Domestic	3 Feedlot	6 Oil field water supply
2 Irrigation	4 Industrial	7 Lawn and garden only
		10 Monitoring well

Was a chemical/bacteriological sample submitted to Department? Yes.....No ; If yes, mo/day/yr sample was submitted

Water Well Disinfected? Yes No

5 TYPE OF BLANK CASING USED:

1 Steel	3 RMP (SR)	5 Wrought iron	8 Concrete tile	CASING JOINTS: Glued Clamped
2 PVC	4 ABS	6 Asbestos-Cement	9 Other (specify below)	Welded
		7 Fiberglass		Threaded. <input checked="" type="checkbox"/>

Blank casing diameter **10** in. to **44** ft., Dia. **2** in. to **66** ft., Dia. in. to ft.

Casing height above land surface **28.56** in., weight lbs./ft. Wall thickness or gauge No. **Sch. 40**

TYPE OF SCREEN OR PERFORATION MATERIAL

1 Steel	3 Stainless steel	5 Fiberglass	7 PVC	10 Asbestos-cement
2 Brass	4 Galvanized steel	6 Concrete tile	8 RMP (SR)	11 Other (specify)
			9 ABS	12 None used (open hole)

SCREEN OR PERFORATION OPENINGS ARE:

1 Continuous slot	3 Mill slot	5 Gauzed wrapped	8 Saw cut	11 None (open hole)
2 Louvered shutter	4 Key punched	6 Wire wrapped	9 Drilled holes	
		7 Torch cut	10 Other (specify)	

SCREEN-PERFORATED INTERVALS: From **66** ft. to **71** ft., From ft. to ft.

GRAVEL PACK INTERVALS: From **64** ft. to **64** ft., From ft. to ft.

6 GROUT MATERIAL: 1 Neat cement **2 Cement grout** **3 Bentonite** 4 Other

Grout Intervals: From **0** ft. to **62** ft., From **62** ft. to **64** ft., From ft. to ft.

What is the nearest source of possible contamination:

1 Septic tank	4 Lateral lines	7 Pit privy	10 Livestock pens	14 Abandoned water well
2 Sewer lines	5 Cess pool	8 Sewage lagoon	11 Fuel storage	15 Oil well/Gas well
3 Watertight sewer lines	6 Seepage pit	9 Feedyard	12 Fertilizer storage	16 Other (specify below)
			13 Insecticide storage	

Direction from well? How many feet?

FROM	TO	LITHOLOGIC LOG	FROM	TO	PLUGGING INTERVALS
0	10	Topsoil,	57	57.2	Sand, cemented,
10	16.5	Clay fill	57.2	58	Gypsum, alabaster,
16.5	17	Clay	58	64	Clay, cemented nodules
17	19.5	Clay, calcite nodules	64	65	Clay/weathered shale
19.5	32	Clay,	65	66	Shale, weathered
32	33	Clay, crystalline stringers	66	67	Clay
33	38.5	Clay,	67	67.25	Shale, weathered
38.5	41	Clay w/calcite nodules	67.25	67.75	Clay
41	45.5	Clay,	67.75	74	Shale
45.5	45.75	Clay, cemented nodules			
45.75	47	Clay			
47	47.3	Gypsum, alabaster,			
47.3	52	Clay			BOW2, Abovegrade
52	52.3	Gypsum, alabaster,			
52.3	57	Clay,			

7 CONTRACTOR'S OR LANDOWNER'S CERTIFICATION: This water well was **(1)** constructed, (2) reconstructed, or (3) plugged under my jurisdiction and was completed on (mo/day/year) **1/26/2010** and this record is true to the best of my knowledge and belief.

Kansas Water Well Contractor's License No. **527** This Water Well Record was completed on (mo/day/yr) **2/11/2010**

under the business name of **GeoCore, Inc.** by (signature) *[Signature]*