


1 LOCATION OF WATER WELL: County: Sedgwick	Fraction NW ¼ SE ¼ SW ¼	Section Number 26	Township Number T 25 S	Range Number R 2 E/W
--	-----------------------------------	-----------------------------	----------------------------------	--------------------------------

Distance and direction from nearest town or city street address of well if located within city?

8808 N. 127th St. E, Valley Center

2 WATER WELL OWNER: Chemical Waste Management, Inc. RR# : St. Address, Box # 8808 N. 127th East City, State, ZIP Code : Valley Center, KS 67147	Board of Agriculture, Division of Water Resources Application Number:
--	--

3 LOCATE WELL'S LOCATION WITH AN "X" IN SECTION BOX:

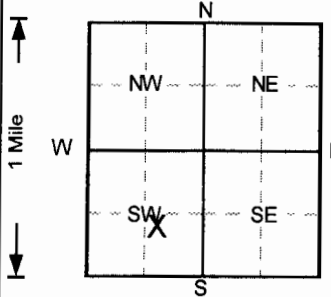

4 DEPTH OF COMPLETED WELL: 50 ft. ELEVATION: 1379.516
Depth(s) Groundwater Encountered 1. ft. 2. ft. 3. ft.
WELL'S STATIC WATER LEVEL . . . 43.5 . . . ft. below land surface measured on mo/day/yr . . . 1/28/2010
Pump test data: Well water was . . . NA . . . ft. after hours pumping gpm
Est. Yield . . . NA . . . gpm: Well water was ft. after hours pumping gpm
Bore Hole Diameter . . . 13 . . . in. to . . . 36 . . . ft. and . . . 8 . . . in. to . . . 50 . . . ft.
WELL WATER TO BE USED AS: 5 Public water supply 8 Air conditioning 11 Injection well 1 Domestic 3 Feedlot 6 Oil field water supply 9 Dewatering 12 Other (Specify below) 2 Irrigation 4 Industrial 7 Lawn and garden only 10 Monitoring well
Was a chemical/bacteriological sample submitted to Department? Yes.....No <input checked="" type="checkbox"/> ; If yes, mo/day/yr sample was submitted
Water Well Disinfected? Yes No <input checked="" type="checkbox"/>

5 TYPE OF BLANK CASING USED: 1 Steel 2 PVC 3 RMP (SR) 4 ABS 5 Wrought iron 6 Asbestos-Cement 7 Fiberglass	8 Concrete tile 9 Other (specify below)	CASING JOINTS: Glued Clamped Welded Threaded. <input checked="" type="checkbox"/>
Blank casing diameter 10 in. to 36 ft. Dia 2 in. to 45 ft. Dia in. to ft.		
Casing height above land surface 30.6 in., weight lbs./ft. Wall thickness or gauge No. Sch. 40		
TYPE OF SCREEN OR PERFORATION MATERIAL 1 Steel 2 Brass 3 Stainless steel 4 Galvanized steel 5 Fiberglass 6 Concrete tile 7 PVC 8 RMP (SR) 9 ABS 10 Asbestos-cement 11 Other (specify) 12 None used (open hole)		
SCREEN OR PERFORATION OPENINGS ARE: 1 Continuous slot 2 Louvered shutter 3 Mill slot 4 Key punched 5 Gauzed wrapped 6 Wire wrapped 7 Torch cut 8 Saw cut 9 Drilled holes 10 Other (specify) 11 None (open hole)		
SCREEN-PERFORATED INTERVALS: From 45 ft. to 50 ft. From ft. to ft.		
GRAVEL PACK INTERVALS: From 43 ft. to 50 ft. From ft. to ft.		

6 GROUT MATERIAL: 1 Neat cement 2 Cement grout 3 Bentonite 4 Other	Grout Intervals: From 0 ft. to 41 ft. From 41 ft. to 43 ft. From ft. to ft.
What is the nearest source of possible contamination: 1 Septic tank 2 Sewer lines 3 Watertight sewer lines 4 Lateral lines 5 Cess pool 6 Seepage pit 7 Pit privy 8 Sewage lagoon 9 Feedyard 10 Livestock pens 11 Fuel storage 12 Fertilizer storage 13 Insecticide storage 14 Abandoned water well 15 Oil well/Gas well 16 Other (specify below)	
Direction from well? How many feet?	

FROM	TO	LITHOLOGIC LOG	FROM	TO	PLUGGING INTERVALS
0	1	Topsoil,	40	42	Clay, mudstone fragments
1	6.5	Clay	42	46	Clay, caliche nodules
6.5	7	Clay w/sand	46	50	Shale,
7	10	Clay w/caliche sand streaks			
10	15	Clay			
15	17	Clay w/sand calcite lenses, Brown			
17	17.5	Clay			
17.5	20	Clay/weathered shale			
20	20.5	Clay			
20.5	23	Shale, weathered			
23	25	Clay, boxwork calcite @24-24.5			
25	26	Clay			
26	26.5	Clay, boxwork calcite			BP01 , Abovegrade
26.5	30.5	Clay, calcite veins			
30.5	40	Clay,			

7 CONTRACTOR'S OR LANDOWNER'S CERTIFICATION: This water well was (1) constructed, (2) reconstructed, or (3) plugged under my jurisdiction and was completed on (mo/day/year) 1/26/2010 and this record is true to the best of my knowledge and belief.
Kansas Water Well Contractor's License No. 527 This Water Well Record was completed on (mo/day/yr) 2/19/2010 under the business name of GeoCore, Inc. by (signature) <i>Dale Kahl</i>