


1 LOCATION OF WATER WELL: County: **Sedgwick** Fraction: **NW 1/4 NE 1/4 SW 1/4** Section Number: **28** Township Number: **T 25 S** Range Number: **R 2 E/W**

Distance and direction from nearest town or city street address of well if located within city?  
**8808 N. 127th St. E, Valley Center**

2 WATER WELL OWNER: **Chemical Waste Management, Inc.**  
 RR#, St. Address, Box #: **8808 N. 127th East**  
 City, State, ZIP Code: **Valley Center, KS 67147**  
 Board of Agriculture, Division of Water Resources  
 Application Number:

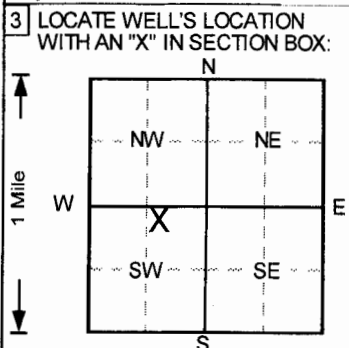

4 DEPTH OF COMPLETED WELL: **58** ft. ELEVATION: **1374.541**  
 Depth(s) Groundwater Encountered 1. . . . . ft. 2. . . . . ft. 3. . . . . ft.  
 WELL'S STATIC WATER LEVEL: **42.2** ft. below land surface measured on mo/day/yr **1/28/2010**  
 Pump test data: Well water was **NA** ft. after . . . . . hours pumping . . . . . gpm  
 Est. Yield: **NA** gpm: Well water was . . . . . ft. after . . . . . hours pumping . . . . . gpm  
 Bore Hole Diameter: **13** in. to **32** ft., and **8** in. to **58** ft.  
 WELL WATER TO BE USED AS: 5 Public water supply 8 Air conditioning 11 Injection well  
 1 Domestic 3 Feedlot 6 Oil field water supply 9 Dewatering 12 Other (Specify below)  
 2 Irrigation 4 Industrial 7 Lawn and garden only **10 Monitoring well**  
 Was a chemical/bacteriological sample submitted to Department? Yes. . . . . No  ; If yes, mo/day/yr sample was submitted  
 Water Well Disinfected? Yes No

5 TYPE OF BLANK CASING USED: 5 Wrought iron 8 Concrete tile CASING JOINTS: Glued . . . . . Clamped . . . . .  
 1 Steel 3 RMP (SR) 6 Asbestos-Cement 9 Other (specify below) Welded . . . . .  
**2 PVC** 4 ABS 7 Fiberglass Threaded   
 Blank casing diameter: **10** in. to **32** ft., Dia. **2** in. to **53** ft., Dia. . . . . in. to . . . . . ft.  
 Casing height above land surface: **26.04** in., weight . . . . . lbs./ft. Wall thickness or gauge No. **Sch. 40**

TYPE OF SCREEN OR PERFORATION MATERIAL: **7 PVC** 10 Asbestos-cement  
 1 Steel 3 Stainless steel 5 Fiberglass 8 RMP (SR) 11 Other (specify) . . . . .  
 2 Brass 4 Galvanized steel 6 Concrete tile 9 ABS 12 None used (open hole)

SCREEN OR PERFORATION OPENINGS ARE: 5 Gauzed wrapped 8 Saw cut 11 None (open hole)  
 1 Continuous slot **3 Mill slot** 6 Wire wrapped 9 Drilled holes  
 2 Louvered shutter 4 Key punched 7 Torch cut 10 Other (specify) . . . . .

SCREEN-PERFORATED INTERVALS: From . . . . . **53** . . . . . ft. to . . . . . **58** . . . . . ft., From . . . . . ft. to . . . . . ft.  
 From . . . . . ft. to . . . . . ft., From . . . . . ft. to . . . . . ft.  
 GRAVEL PACK INTERVALS: From . . . . . **51** . . . . . ft. to . . . . . **58** . . . . . ft., From . . . . . ft. to . . . . . ft.  
 From . . . . . ft. to . . . . . ft., From . . . . . ft. to . . . . . ft.

6 GROUT MATERIAL: 1 Neat cement **2 Cement grout** **3 Bentonite** 4 Other . . . . .  
 Grout intervals: From . . . . . **0** . . . . . ft. to . . . . . **49** . . . . . ft., From . . . . . **49** . . . . . ft. to . . . . . **51** . . . . . ft., From . . . . . ft. to . . . . . ft.

What is the nearest source of possible contamination:  
 1 Septic tank 4 Lateral lines 7 Pit privy 10 Livestock pens 14 Abandoned water well  
 2 Sewer lines 5 Cess pool 8 Sewage lagoon 11 Fuel storage 15 Oil well/Gas well  
 3 Watertight sewer lines 6 Seepage pit 9 Feedyard 12 Fertilizer storage 16 Other (specify below)  
 13 Insecticide storage  
 Direction from well? How many feet?

FROM	TO	LITHOLOGIC LOG	FROM	TO	PLUGGING INTERVALS
0	1	Clay	45	46.5	Clay, w/mudstone fragments
1	2.4	Topsoil,	46.5	47.5	Clay w/tan clay lenses
2.4	12	Clay, with caliche nodules	47.5	53	Clay,
12	17.5	Clay, w/caliche streaks	53	54	Clay, w/calcite seams,
17.5	24	Shale and clay w/caliche modules	54	55.5	Clay
24	30	Clay, w/calcite nodules and veins	55.5	56.5	Clay w/occ. gravel seam,
30	32.5	Clay	56.5	57.3	Clay
32.5	33	Clay w/sandstone fragments	57.3	58	Gypsum, alabaster,
33	37	Clay w/mudstone frags, caliche nodules			
37	40	Shale, weathered			
40	42	Clay			
42	42.5	Clay, w/clay lenses,			
42.5	43	Clay,			B412, Abovegrade
43	44.5	Clay			
44.5	45	Shale, weathered			

7 CONTRACTOR'S OR LANDOWNER'S CERTIFICATION: This water well was **(1)** constructed, (2) reconstructed, or (3) plugged under my jurisdiction and was completed on (mo/day/year) **1/26/2010** and this record is true to the best of my knowledge and belief.  
 Kansas Water Well Contractor's License No. **527** This Water Well Record was completed on (mo/day/yr) **2/19/2010**  
 under the business name of **GeoCore, Inc.** by (signature) *John Kelly*

OFFICE USE ONLY  
T  
R  
EW  
SEC.  
1/4  
1/4  
1/4