

County: Sedgwick Fraction SW NE SW Sec. 26 T 25 S R 2 (E/W)

**CORRECTION(S) TO WATER WELL COMPLETION RECORD (WWC-5)**

(to rectify lacking or incorrect information)

Owner: Chemical Waste Management, Inc.

Location was listed as:

Location changed to:

Section-Township-Range: 26-255-3E

26-255-2E

Fraction (1/4 1/4 1/4): SW NE SW

SW NE SW

Other changes: Initial statements: \_\_\_\_\_

Changed to: \_\_\_\_\_

Comments: \_\_\_\_\_

Verification method: Written & legal description, area road map, position on plat map, other monitoring well records for same owner nearby, and mapping tool on KGS website initials: DRR date: 7/3/2013

Submitted by: Kansas Geological Survey, Data Resources Library, 1930 Constant Ave., Lawrence, KS 66047-3726  
to: Kansas Dept of Health & Environment, Bureau of Water, 1000 SW Jackson, Suite 420, Topeka, KS 66612-1367.


WATER WELL RECORD Form WWC-5 KSA 82a-1212

1 LOCATION OF WATER WELL: Fraction **SW 1/4 NE 1/4 SW 1/4** Section Number **26** Township Number **T 25 S** Range Number **R 3** **E/W**  
 County: **Sedgwick**

Distance and direction from nearest town or city street address of well if located within city?  
**8808 N. 127th St. E, Valley Center**

2 WATER WELL OWNER: **Chemical Waste Management, Inc.**  
 RR#, St. Address, Box # : **8808 N. 127th East** Board of Agriculture, Division of Water Resources  
 City, State, ZIP Code : **Valley Center, KS 67147** Application Number:

3 LOCATE WELL'S LOCATION WITH AN "X" IN SECTION BOX:

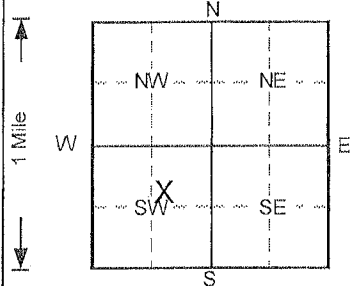

4 DEPTH OF COMPLETED WELL . . . . . **38.5** . . . . . ft. ELEVATION: . . . . . **1368.69** . . . . . ft.  
 Depth(s) Groundwater Encountered 1. . . . . ft. 2. . . . . ft. 3. . . . . ft.  
 WELL'S STATIC WATER LEVEL . . . . . ft. below land surface measured on mo/day/yr . . . . .  
 Pump test data: Well water was . . . . . **NA** . . . . . ft. after . . . . . hours pumping . . . . . gpm  
 Est. Yield . . . . . **NA** . . . . . gpm: Well water was . . . . . ft. after . . . . . hours pumping . . . . . gpm  
 Bore Hole Diameter . . . . . **13** . . . . . in. to . . . . . **23** . . . . . ft., and . . . . . **8** . . . . . in. to . . . . . **40** . . . . . ft.  
 WELL WATER TO BE USED AS: 5 Public water supply 8 Air conditioning 11 Injection well  
 1 Domestic 3 Feedlot 6 Oil field water supply 9 Dewatering 12 Other (Specify below)  
 2 Irrigation 4 Industrial 7 Lawn and garden only **10** Monitoring well  
 Was a chemical/bacteriological sample submitted to Department? Yes.....No  ; If yes, mo/day/yr sample was submitted  
 Water Well Disinfecta? Yes No

5 TYPE OF BLANK CASING USED: 5 Wrought iron 8 Concrete tile CASING JOINTS: Glued . . . . . Clamped . . . . .  
 1 Steel 3 RMP (SR) 6 Asbestos-Cement 9 Other (specify below) Welded . . . . .  
**2** PVC 4 ABS 7 Fiberglass Threaded.   
 Blank casing diameter . . . . . **10** . . . . . in. to . . . . . **23** . . . . . ft., Dia . . . . . **2** . . . . . in. to . . . . . **33.5** . . . . . ft., Dia . . . . . in. to . . . . . ft.  
 Casing height above land surface . . . . . **31.44** . . . . . in., weight . . . . . lbs./ft. Wall thickness or gauge No. . . . . **Sch. 40** . . . . .  
 TYPE OF SCREEN OR PERFORATION MATERIAL **7** PVC 10 Asbestos-cement  
 1 Steel 3 Stainless steel 5 Fiberglass 8 RMP (SR) 11 Other (specify) . . . . .  
 2 Brass 4 Galvanized steel 6 Concrete tile 9 ABS 12 None used (open hole)  
 SCREEN OR PERFORATION OPENINGS ARE: 5 Gauzed wrapped 8 Saw cut 11 None (open hole)  
 1 Continuous slot **3** Mill slot 6 Wire wrapped 9 Drilled holes  
 2 Louvered shutter 4 Key punched 7 Torch cut 10 Other (specify) . . . . .  
 SCREEN-PERFORATED INTERVALS: From . . . . . **33.5** . . . . . ft. to . . . . . **38.5** . . . . . ft., From . . . . . ft. to . . . . . ft.  
 From . . . . . ft. to . . . . . ft., From . . . . . ft. to . . . . . ft.  
 GRAVEL PACK INTERVALS: From . . . . . **31** . . . . . ft. to . . . . . **40** . . . . . ft., From . . . . . ft. to . . . . . ft.  
 From . . . . . ft. to . . . . . ft., From . . . . . ft. to . . . . . ft.

6 GROUT MATERIAL: 1 Neat cement **2** Cement grout **3** Bentonite 4 Other . . . . .  
 Grout intervals: From . . . . . **0** . . . . . ft. to . . . . . **23** . . . . . ft., From . . . . . **23** . . . . . ft. to . . . . . **31** . . . . . ft., From . . . . . ft. to . . . . . ft.  
 What is the nearest source of possible contamination:  
 1 Septic tank 4 Lateral lines 7 Pit privy 10 Livestock pens 14 Abandoned water well  
 2 Sewer lines 5 Cess pool 8 Sewage lagoon 11 Fuel storage 15 Oil well/Gas well  
 3 Watertight sewer lines 6 Seepage pit 9 Feedyard 12 Fertilizer storage **16** Other (specify below)  
 . . . . . **Waste disposal facility.**  
 13 Insecticide storage  
 Direction from well? **North** How many feet? **260**

FROM	TO	LITHOLOGIC LOG	FROM	TO	PLUGGING INTERVALS
0	1	Topsoil,			
1	5	Clay, w/lg gravel, Brown			
5	12	Clay, silty, Dark Brown to Yellow			
12	15	Shale, w/thrd., Gray-Tan			
15	23.5	Clay, silty,			
23.5	27	Clay w/shale, Tan			
27	28	Clay, w/sand, Brown			
28	30	Clay w/shale sand, Tan			
30	32	Clay, silty, Tan and Gray			
32	32.5	Clay w/shale, Gray			
32.5	40	Shale			
					B414, Abovegrade

7 CONTRACTOR'S OR LANDOWNER'S CERTIFICATION: This water well was **1** constructed, **2** reconstructed, or **3** plugged under my jurisdiction and was completed on (mo/day/year) . . . . . **2/11/2011** . . . . . and this record is true to the best of my knowledge and belief.  
 Kansas Water Well Contractor's License No. . . . . **527** . . . . . This Water Well Record was completed on (mo/day/yr) **3/9/2011** . . . . .  
 under the business name of **GeoCore, Inc.** by (signature) *Dale Wolf*

INSTRUCTIONS: Use typewriter or ball point pen. PLEASE PRESS FIRMLY and PRINT clearly. Please fill in blanks, underline or circle the correct answers. Send top three copies to Kansas Department of Health and Environment, Bureau of Water, Topeka, Kansas 66620-0001. Telephone: 913-296-5545. Send one to WATER WELL OWNER and retain one for your records.

OFFICE USE ONLY  
T  
R  
SEC.  
1/4  
1/4  
1/4