


**WATER WELL PLUGGING RECORD Form WWC-5P KSA 82a-1212 ID NO.**

--

<b>1 LOCATION OF WATER WELL:</b>	Fraction County: <b>Sedgwick</b> <b>NW ¼ NE ¼ SW ¼</b>	Section Number <b>26</b>	Township Number <b>25S</b>	Range Number <b>2 E</b>
----------------------------------	---	-----------------------------	-------------------------------	----------------------------

Distance and direction from nearest town or city street address of well if located within city?  
**3 miles southeast of Furley**

<b>2 WATER WELL OWNER: Chemical Waste Management, Inc.</b>  RR#, St. Address, Box #: <b>8808 N. 127<sup>th</sup> E.</b>  City, State, ZIP Code: <b>Valley Center, KS 67147</b>	<b>Global Positioning System</b> (decimal degrees, min. of 4 digits) Latitude: <u>1744874.71</u> Northing Longitude: <u>169237.91</u> Easting Elevation: <u>1383.78</u> TOC Datum: <u>Vertical 29 Kansas South SPC</u> Data Collection Method: _____
--	---

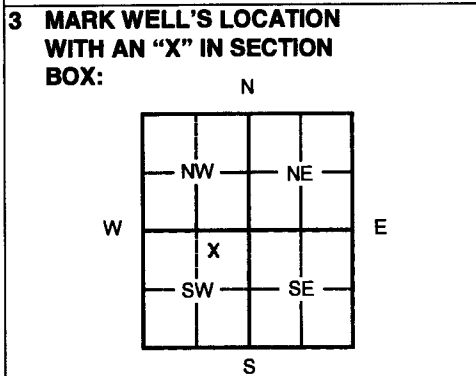

**4 DEPTH OF WELL** 53 ft.

WELL'S STATIC WATER LEVEL 47.10 ft

WELL WAS USED AS:

1 Domestic	5 Public Water Supply	9 Dewatering
2 Irrigation	6 Oil Field Water Supply	10 <b>Monitoring</b>
3 Feedlot	7 Domestic (Lawn & Garden)	11 Injection Well
4 Industrial	8 Air Conditioning	12 Other _____

Was a chemical/bacteriological sample submitted to Department? Yes \_\_\_ No X

**5 TYPE OF BLANK CASING USED:**

1 Steel	3 RMP (SR)	5 Wrought	7 Fiberglass	9 Other (Specify below)
2 <b>PVC</b>	4 ABS	6 Asbestos-Cement	8 Concrete Tile	_____

Blank casing diameter 10/4\* in. Was casing pulled? Yes X No \_\_\_ If yes, how much 3 ft. of each casing

Casing height above or below land surface 36 in.

**6 GROUT PLUG MATERIAL:**    1 Neat cement    2 Cement grout    3 **Bentonite**    4 Other \_\_\_\_\_

Grout Plug Intervals: From 3 ft. to 53 ft., From \_\_\_\_\_ ft. to \_\_\_\_\_ ft., From \_\_\_\_\_ to \_\_\_\_\_ ft.

What is the nearest source of possible contamination:

1 Septic tank	6 Seepage pit	11 Fuel Storage	16 Other (specify below)
2 Sewer lines	7 Pit privy	12 Fertilizer storage	_____
3 Watertight sewer lines	8 Sewage lagoon	13 Insecticide storage	_____
4 Lateral lines	9 Feedyard	14 Abandoned water well	Direction from well?
5 Cess pool	10 Livestock pens	15 Oil well/Gas well	How many feet?

FROM	TO	PLUGGING MATERIALS	FROM	TO	PLUGGING MATERIALS
0	3	Native Soil			* 10" outer casing to 40' bgs, with 4" inner casing to 53' bgs
3	53	Bentonite			

**7 CONTRACTOR'S OR LANDOWNER'S CERTIFICATION:** This water well was plugged under my jurisdiction and was completed on (mo/day/year) 04/25/12 and this record is true to the best of my knowledge and belief. Kansas Water Well Contractor's License No. 531. This Water Well Record was completed on (mo/day/year) 05/30/12 under the business name of Geotechnical Services, Inc. by (signature)

**INSTRUCTIONS:** Please fill in blanks or circle the correct answers. Send top three copies to Kansas Department of Health and Environment, Bureau of Water, Geology Section, 1000 SW Jackson St., Ste. 420, Topeka, Kansas 66612-1367. Telephone: 785/296-5522. Send one to Water Well Owner and retain one for your records. Visit us at <http://www.kdheks.gov/waterwell>.