

Mod. B 260


1 LOCATION OF WATER WELL: County: SEDGWICK Fraction: NW 1/4 NW 1/4 NW 1/4 Section Number: 26 Township Number: T 25 S Range Number: R 2 EW

Distance and direction from nearest town or city street address of well if located within city?

3 miles S.E. of FURLEY, Ks.

2 WATER WELL OWNER: NIES RR#, St. Address, Box #: 8808 N. 127th East City, State, ZIP Code: VALLEY CENTER, Ks. 67147 Board of Agriculture, Division of Water Resources Application Number:

3 LOCATE WELL'S LOCATION WITH AN "X" IN SECTION BOX:

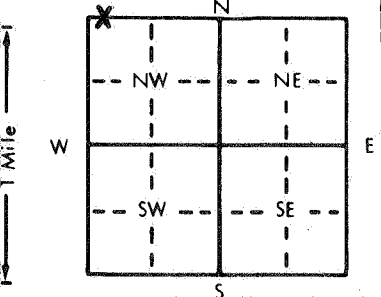

4 DEPTH OF COMPLETED WELL: 12.0 ft. ELEVATION: 1336.8

Depth(s) Groundwater Encountered 1. 6.8 ft. 2. NA Pump test data: Well water was NA ft. after NA hours pumping NA gpm Est. Yield NA gpm Well water was NA ft. after NA hours pumping NA gpm Bore Hole Diameter 6 in. to 12.0 ft. and NA in. to NA ft. WELL WATER TO BE USED AS: 5 Public water supply 8 Air conditioning 11 Injection well 1 Domestic 3 Feedlot 6 Oil field water supply 9 Dewatering 12 Other (Specify below) 2 Irrigation 4 Industrial 7 Lawn and garden only 10 Observation well MONITORING Well Was a chemical/bacteriological sample submitted to Department? Yes [X] No [ ] If yes, mo/day/yr sample was submitted 3/3+19/82 Water Well Disinfected? Yes [ ] No [X]

5 TYPE OF BLANK CASING USED: 1 Steel 3 RMP (SR) 5 Wrought iron 8 Concrete tile CASING JOINTS: Glued [ ] Clamped [ ] 2 PVC 4 ABS 6 Asbestos-Cement 9 Other (specify below) Welded [ ] Threaded [X] 7 Fiberglass

Blank casing diameter 2 in. to 5.7 ft. Dia. 2.2pt. weight 0.70 lbs./ft. Wall thickness or gauge No. SCH. 40

TYPE OF SCREEN OR PERFORATION MATERIAL: 1 Steel 3 Stainless steel 5 Fiberglass 7 PVC 10 Asbestos-cement 2 Brass 4 Galvanized steel 6 Concrete tile 8 RMP (SR) 11 Other (specify) 12 None used (open hole)

SCREEN OR PERFORATION OPENINGS ARE: 1 Continuous slot 3 Mill slot 5 Gauzed wrapped 8 Saw cut 11 None (open hole) 2 Louvered shutter 4 Key punched 6 Wire wrapped 9 Drilled holes 7 Torch cut 10 Other (specify)

SCREEN-PERFORATED INTERVALS: From 5.7 ft. to 10.7 ft. GRAVEL PACK INTERVALS: From 4.8 ft. to 12.0 ft.

6 GROUT MATERIAL: 1 Neat cement 2 Cement grout 3 Bentonite 4 Other Grout Intervals: From 0.0 ft. to 4.8 ft.

What is the nearest source of possible contamination: 1 Septic tank 4 Lateral lines 7 Pit privy 10 Livestock pens 14 Abandoned water well 2 Sewer lines 5 Cess pool 8 Sewage lagoon 11 Fuel storage 15 Oil well/Gas well 3 Watertight sewer lines 6 Seepage pit 9 Feedyard 12 Fertilizer storage 16 Other (specify below) 13 Insecticide storage BRINE DISPOSAL Well How many feet? APPROX. 760

Direction from well? ESE

Table with columns FROM, TO, LITHOLOGIC LOG. Entry: FROM 0.0 FT. TO 12.0 FT. LITHOLOGIC LOG: BROWN, PLASTIC CLAY WITH TRACE CALCIUM CARBONATE NODULES TO GRAY MEDIUM PLASTIC SILTY CLAY (PROBABLY WEATHERED CLAY)


7 CONTRACTOR'S OR LANDOWNER'S CERTIFICATION: This water well was (1) constructed (2) reconstructed, or (3) plugged under my jurisdiction and was completed on (mo/day/year) 2/23/82 and this record is true to the best of my knowledge and belief. Kansas Water Well Contractor's License No. 416 This Water Well Record was completed on (mo/day/yr) 5/19/82 under the business name of TERAACON CONSULTANTS INC. by signature [Signature]

INSTRUCTIONS: Use typewriter or ball point pen, PLEASE PRESS FIRMLY and PRINT clearly. Please fill in blanks, underline or circle the correct answers. Send top three copies to Kansas Department of Health and Environment, Division of Environment, Environmental Geology Section, Topeka, KS 66620. Send one to WATER WELL OWNER and retain one for your records.