


LOCATION OF WATER WELL: Fraction SE 1/4 NW 1/4 SW 1/4 Section Number 26 Township Number T 25 S Range Number R 02 EW

Distance and direction from nearest town or city street address of well if located within city? County: Sedgwick Approx. 3 miles Southeast of Furley, Kansas

WATER WELL OWNER: RR#, St. Address, Box #: N.E.S. 8808 North, 127th Street East Board of Agriculture, Division of Water Resources City, State, ZIP Code: Valley Center, Kansas 67147 Application Number:

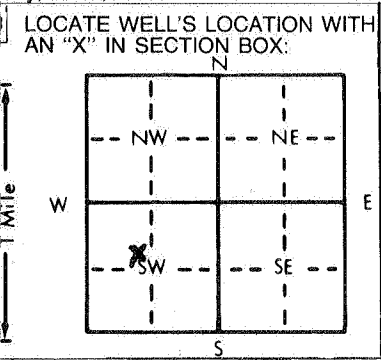

LOCATE WELL'S LOCATION WITH AN 'X' IN SECTION BOX: DEPTH OF COMPLETED WELL: 55.5 ft. ELEVATION: 1325.4 ft. WELL'S STATIC WATER LEVEL: 43.7 ft. below land surface measured on 08/08/84. Pump test data: Well water was NA ft. after hours pumping gpm. Est. Yield gpm: Well water was ft. after hours pumping gpm. Bore Hole Diameter: 14 in. to 4.0 ft., and 7 7/8 in. to 56.0 ft. WELL WATER TO BE USED AS: 5 Public water supply, 8 Air conditioning, 11 Injection well, 12 Other (Specify below) Monitoring Well. Was a chemical/bacteriological sample submitted to Department? Yes. No. If yes, mo/day/yr sample was submitted 06/14/84. Water Well Disinfected? Yes No

TYPE OF BLANK CASING USED: 1 Steel, 2 PVC, 3 RMP (SR), 4 ABS, 5 Wrought iron, 6 Asbestos-Cement, 7 Fiberglass, 8 Concrete tile, 9 Other (specify below), 10 Asbestos-cement, 11 Other (specify), 12 None used (open hole). CASING JOINTS: Glued, Clamped, Welded, Threaded. Blank casing diameter 10 in. to 40.9 ft., Dia 4 in. to 49.5 ft., Dia. Casing height above land surface 2.4 ft., weight 10in=8; 4in=2 lbs./ft. Wall thickness or gauge No. Sch. 40

TYPE OF SCREEN OR PERFORATION MATERIAL: 1 Steel, 2 Brass, 3 Stainless steel, 4 Galvanized steel, 5 Fiberglass, 6 Concrete tile, 7 PVC, 8 RMP (SR), 9 ABS, 10 Asbestos-cement, 11 Other (specify), 12 None used (open hole). SCREEN OR PERFORATION OPENINGS ARE: 1 Continuous slot, 2 Louvered shutter, 3 Mill slot, 4 Key punched, 5 Gauzed wrapped, 6 Wire wrapped, 7 Torch cut, 8 Saw cut, 9 Drilled holes, 10 Other (specify), 11 None (open hole)

SCREEN-PERFORATED INTERVALS: From 49.5 ft. to 53.6 ft. GRAVEL PACK INTERVALS: From 44.9 ft. to 55.5 ft.

GROUT MATERIAL: 1 Neat cement, 2 Cement grout, 3 Bentonite, 4 Other. Grout Intervals: From 56.0 ft. to 0.0 ft. What is the nearest source of possible contamination: Disp. Trench 029/30, 10 Livestock pens, 14 Abandoned water well, 11 Fuel storage, 15 Oil well/Gas well, 12 Fertilizer storage, 16 Other (specify below) Haz. Waste Facility, 13 Insecticide storage, 9 Feedyard. Direction from well? North. How many feet? Approx. 20

LITHOLOGIC LOG table with columns FROM, TO, and LITHOLOGIC LOG. Entries include: 0 ft to ~46 ft: Brown, plastic to highly plastic CLAY to weathered CLAY-SHALE with trace to some Calcium carbonate nodules; ~46 ft to 55.5 ft: BEDROCK - Intertbedded GYPSUM and gray SHALE.

CONTRACTOR'S OR LANDOWNER'S CERTIFICATION: This water well was (1) constructed, (2) reconstructed, or (3) plugged under my jurisdiction and was completed on 08/31/84 and this record is true to the best of my knowledge and belief. Kansas Water Well Contractor's License No. 416. This Water Well Record was completed on 10-23 under the business name of Terracon Consultants, Inc. by signature [Signature]. INSTRUCTIONS: Use typewriter or ball point pen, PLEASE PRESS FIRMLY and PRINT clearly. Please fill in blanks, underline or circle the correct answers. Send top three copies to Kansas Department of Health and Environment, Division of Environment, Environmental Geology Section, Topeka, KS 66620. Send one to WATER WELL OWNER and retain one for your records.