


1 LOCATION OF WATER WELL: County: Sedgewick Fraction: NE 1/4 NW 1/4 NW 1/4 Section Number: 12 Township Number: T 25 S Range Number: R 2 E

Distance and direction from nearest town or city street address of well if located within city?  
7 E 2 1/2 No Sunnydale Kc.

2 WATER WELL OWNER: Ed. Beasley  
 RR#, St. Address, Box #: #1 Bx 1213  
 City, State, ZIP Code: Valley Center KS 67147  
 Board of Agriculture, Division of Water Resource  
 Application Number:

3 LOCATE WELL'S LOCATION WITH AN "X" IN SECTION BOX:

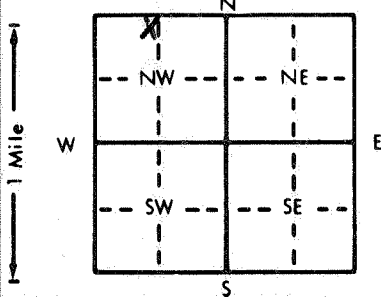

4 DEPTH OF COMPLETED WELL: 65 ft. ELEVATION:  
 Depth(s) Groundwater Encountered 1. 51 ft. 2. ft. 3. ft.  
 WELL'S STATIC WATER LEVEL: 25 ft. below land surface measured on mo/day/yr 11-20-86  
 Pump test data: Well water was 51 ft. after 1/2 hours pumping 10 gpm  
 Est. Yield 10-15 gpm: Well water was ft. after hours pumping gpm  
 Bore Hole Diameter: 11 in. to 65 ft., and in. to ft.  
 WELL WATER TO BE USED AS:  
 1 Domestic  3 Feedlot  6 Oil field water supply  9 Dewatering  12 Other (Specify below)  
 2 Irrigation  4 Industrial  7 Lawn and garden only  10 Observation well  
 Was a chemical/bacteriological sample submitted to Department? Yes.....No..... If yes, mo/day/yr sample was submitted  
 Water Well Disinfected? Yes  No

5 TYPE OF BLANK CASING USED:  
 1 Steel  3 RMP (SR)  5 Wrought iron  8 Concrete tile  CASING JOINTS: Glued  Clamped.....  
 2 PVC  4 ABS  6 Asbestos-Cement  9 Other (specify below) Welded.....  
 7 Fiberglass  Threaded.....  
 Blank casing diameter: 5 in. to 21 ft., Dia. in. to ft., Dia. in. to ft.  
 Casing height above land surface: 12 in., weight 1.59 lbs./ft. Wall thickness or gauge No. SPR-26

TYPE OF SCREEN OR PERFORATION MATERIAL:  
 1 Steel  3 Stainless steel  5 Fiberglass  7 PVC  10 Asbestos-cement   
 2 Brass  4 Galvanized steel  6 Concrete tile  8 RMP (SR)  11 Other (specify).....  
 12 None used (open hole)

SCREEN OR PERFORATION OPENINGS ARE:  
 1 Continuous slot  3 Mill slot  5 Gauzed wrapped  8 Saw cut  11 None (open hole)  
 2 Louvered shutter  4 Key punched  6 Wire wrapped  9 Drilled holes   
 7 Torch cut  10 Other (specify).....

SCREEN-PERFORATED INTERVALS: From 21 ft. to 65 ft., From ft. to ft.  
 From ft. to ft., From ft. to ft.  
 GRAVEL PACK INTERVALS: From 13 ft. to 65 ft., From ft. to ft.  
 From ft. to ft., From ft. to ft.

6 GROUT MATERIAL: 1 Neat cement  2 Cement grout  3 Bentonite  4 Other.....  
 Grout Intervals: From 3 ft. to 13 ft., From ft. to ft., From ft. to ft.  
 What is the nearest source of possible contamination:  
 1 Septic tank  4 Lateral lines  7 Pit privy  10 Livestock pens  14 Abandoned water well   
 2 Sewer lines  5 Cess pool  8 Sewage lagoon  11 Fuel storage  15 Oil well/Gas well   
 3 Watertight sewer lines  6 Seepage pit  9 Feedyard  12 Fertilizer storage  16 Other (specify below).....  
 13 Pesticide storage.....  
 Direction from well? SE How many feet? 150

FROM	TO	LITHOLOGIC LOG	FROM	TO	LITHOLOGIC LOG
0	2	Top soil			
2	26	clay			
26	65	Gray shale			

7 CONTRACTOR'S OR LANDOWNER'S CERTIFICATION: This water well was (1) constructed, (2) reconstructed, or (3) plugged under my jurisdiction and was completed on (mo/day/year) 11-20-86 and this record is true to the best of my knowledge and belief. Kansas Water Well Contractor's License No. 318 This Water Well Record was completed on (mo/day/yr) 11-20-86 under the business name of Werninger Dully by (signature) [Signature]

INSTRUCTIONS: Use typewriter or ball point pen. PLEASE PRESS FIRMLY and PRINT clearly. Please fill in blanks, underline or circle the correct answers. Send top three copies to Kansas Department of Health and Environment, Office of Oil Field and Environmental Geology, Regulation and Permitting Section, Topeka, Kansas 66620-7500, Telephone: 913-862-9360. Send one to WATER WELL OWNER and retain one for your records.