
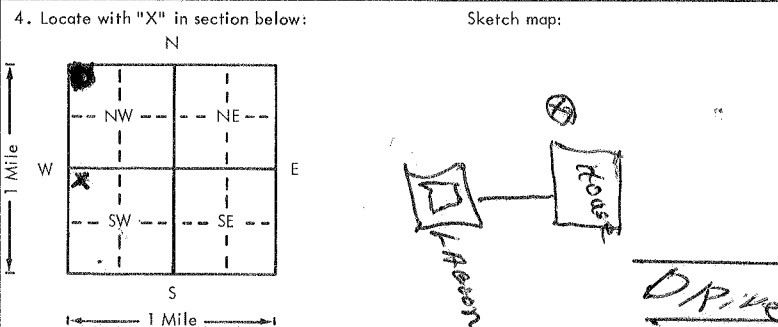


USE TYPEWRITER OR BALL POINT PEN-PRESS FIRMLY, PRINT CLEARLY.

WATER WELL RECORD
KSA 82a-1201-1215

Kansas Department of Health and Environment-Division of Environment (Water well Contractors) Topeka, Kansas 66620

| | |
|--|--------------|
| 1. Location of well: County <u>Sedowick</u> Fraction <u>NW 1/4 NW 1/4 SW 1/4</u> Section number <u>25</u> Township number <u>T 25 S R 2</u> Range number <u>2</u>  | |
| 2. Distance and direction from nearest town or city: <u>1 1/2 W. 3 No.</u> 3. Owner of well: <u>Don Potter</u> Street address of well location if in city: <u>2 W. 1/2 No.</u> R.R. or street: City, state, zip code: <u>Benton, KS 67017</u> | |
| 4. Locate with "X" in section below: Sketch map:  | |
| 5. Type and color of material | |
| 6. Bore hole dia. <u>8 3/4</u> in. Completion date <u>6-28-78</u> Well depth <u>70</u> ft. | |
| 7. <input type="checkbox"/> Cable tool <input checked="" type="checkbox"/> Rotary <input type="checkbox"/> Driven <input type="checkbox"/> Dug <input type="checkbox"/> Hollow rod <input type="checkbox"/> Jetted <input type="checkbox"/> Bored <input type="checkbox"/> Reverse rotary | |
| 8. Use: <input checked="" type="checkbox"/> Domestic <input type="checkbox"/> Public supply <input type="checkbox"/> Industry <input type="checkbox"/> Irrigation <input type="checkbox"/> Air conditioning <input type="checkbox"/> Stock <input type="checkbox"/> Lawn <input type="checkbox"/> Oil field water <input type="checkbox"/> Other | |
| 9. Casing: Material <u>pvc</u> Height: <u>above</u> or below Threaded <input type="checkbox"/> Welded <input type="checkbox"/> Surface <u>13</u> in. RMP <input type="checkbox"/> PVC <u>GT.</u> Weight _____ lbs./ft. Dia. <u>5</u> in. to <u>60</u> ft. depth; Wall Thickness: inches or Dia. _____ in. to _____ ft. depth; gage No. <u>258</u> | |
| 10. Screen: Manufacturer's name <u>M.P.I.</u> Type <u>P.V.C.</u> Dia. <u>5</u> Sieve gauze <u>25/1000</u> Length <u>10</u> Set between <u>60</u> ft. and _____ ft. _____ ft. and _____ ft. Gravel pack? <u>yes</u> Size range of material <u>5/8</u> | |
| 11. Static water level: _____ mo./day/yr. <u>16</u> ft. below land surface Date <u>6-28-78</u> | |
| 12. Pumping level below land surfaces: _____ ft. after _____ hrs. pumping _____ g.p.m. _____ ft. after _____ hrs. pumping _____ g.p.m. Estimated maximum yield _____ g.p.m. | |
| 13. Water sample submitted: _____ mo./day/yr. <input type="checkbox"/> Yes <input checked="" type="checkbox"/> No Date <u>6-28-78</u> | |
| 14. Well head completion: <u>CAP</u> <input type="checkbox"/> Pitless adapter <u>13</u> inches above grade | |
| 15. Well grouted? <u>yes</u> With: <input checked="" type="checkbox"/> Neat cement <input type="checkbox"/> Bentonite <input type="checkbox"/> Concrete Depth: From <u>0</u> ft. to <u>10</u> ft. | |
| 16. Nearest source of possible contamination: ft. <u>100</u> Direction <u>E</u> Type <u>lagoon</u> Well disinfected upon completion? <input checked="" type="checkbox"/> Yes <input type="checkbox"/> No | |
| 17. Pump: <input checked="" type="checkbox"/> Not installed Manufacturer's name _____ Model number _____ HP _____ Volts _____ Length of drop pipe _____ ft. capacity _____ g.p.m. Type: <input type="checkbox"/> Submersible <input type="checkbox"/> Turbine <input type="checkbox"/> Jet <input type="checkbox"/> Reciprocating <input type="checkbox"/> Centrifugal <input type="checkbox"/> Other | |
| (Use a second sheet if needed) | |
| 18. Elevation: Topography: <input type="checkbox"/> Hill <input type="checkbox"/> Slope <input checked="" type="checkbox"/> Upland <input type="checkbox"/> Valley | 19. Remarks: |
| 20. Water well contractor's certification: This well was drilled under my jurisdiction and this report is true to the best of my knowledge and belief. <u>PREWITT Const.</u> <u>353</u> Business name License No. Address <u>Box 744</u> Signed <u>Clayton E. Prewitt</u> Date <u>6-28-78</u> Authorized representative | |

Forward the white, blue and pink copies to the Department of Health and Environment

Form WWC-5