


1 LOCATION OF WATER WELL: Fraction **NE 1/4 NE 1/4 SW 1/4** Section Number **26** Township Number **T 25 S** Range Number **R 02 EW**
 County: **Sedgwick**

Distance and direction from nearest town or city street address of well if located within city?
3 miles Southeast of Furley, Kansas

2 WATER WELL OWNER: **NIES**
 RR#, St. Address, Box #: **8808 North 127th Street East**
 City, State, ZIP Code: **Valley Center, Kansas 67147**
 Board of Agriculture, Division of Water Resources
 Application Number:

3 LOCATE WELL'S LOCATION WITH AN "X" IN SECTION BOX:

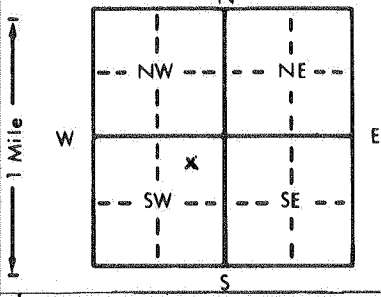

4 DEPTH OF COMPLETED WELL: **37.1** ft. ELEVATION: **1326.0 ft. MSL**

Depth(s) Groundwater Encountered 1. **—** ft. 2. **—** ft. 3. **—** ft.
 WELL'S STATIC WATER LEVEL **27.7** ft. below land surface measured on mo/day/yr **7/9/87**
NA Pump test data: Well water was **—** ft. after **—** hours pumping **—** gpm
 Est. Yield **—** gpm: Well water was **—** ft. after **—** hours pumping **—** gpm
 Bore Hole Diameter **14** in. to **23.1** ft., and **77/8** in. to **37.1** ft.
 WELL WATER TO BE USED AS:
 5 Public water supply 8 Air conditioning 11 Injection well
 1 Domestic 3 Feedlot 6 Oil field water supply 9 Dewatering 12 **Other (Specify below)**
 2 Irrigation 4 Industrial 7 Lawn and garden only 10 Observation well **Monitoring Well**
 Was a chemical/bacteriological sample submitted to Department? Yes **—** No **✓**; If yes, mo/day/yr sample was submitted
 Water Well Disinfected? Yes **—** No **✓**

5 TYPE OF BLANK CASING USED:
 1 Steel 3 RMP (SR) 5 Wrought iron 8 Concrete tile CASING JOINTS: Glued **—** Clamped **—**
 2 **PVC** 4 ABS 6 Asbestos-Cement 9 Other (specify below) Welded **—**
 7 Fiberglass Threaded **✓**

Blank casing diameter **10** in. to **23.1** ft., Dia **4** in. to **31.5** ft., Dia **—** in. to **—** ft.
 Casing height above land surface **2.4** in., weight **10.7 = 8.3**, **4.2 = 2** lbs./ft. Wall thickness or gauge No. **Sch 40**

TYPE OF SCREEN OR PERFORATION MATERIAL:
 1 Steel 3 Stainless steel 5 Fiberglass 8 RMP (SR) 10 Asbestos-cement
 2 Brass 4 Galvanized steel 6 Concrete tile 9 ABS 11 Other (specify) **—**
 12 None used (open hole)

SCREEN OR PERFORATION OPENINGS ARE:
 1 Continuous slot 3 **Mill slot** 5 Gauzed wrapped 8 Saw cut 11 None (open hole)
 2 Louvered shutter 4 Key punched 6 Wire wrapped 9 Drilled holes
 7 Torch cut 10 Other (specify) **—**

SCREEN-PERFORATED INTERVALS: From **31.5** ft. to **36.5** ft., From **—** ft. to **—** ft.
 GRAVEL PACK INTERVALS: From **29.5** ft. to **37.1** ft., From **—** ft. to **—** ft.

6 GROUT MATERIAL: 1 **Neat cement** 2 Cement grout 3 **Bentonite** 4 Other
 Grout Intervals: From **0.0** ft. to **29.5** ft., From **—** ft. to **—** ft., From **—** ft. to **—** ft.

What is the nearest source of possible contamination: **North Disposal Area**
 1 Septic tank 4 Lateral lines 7 Pit privy 10 Livestock pens 14 Abandoned water well
 2 Sewer lines 5 Cess pool 8 Sewage lagoon 11 Fuel storage 15 Oil well/Gas well
 3 Watertight sewer lines 6 Seepage pit 9 Feedyard 12 Fertilizer storage 16 **Other (specify below)**
Haz. Waste Facility
 Direction from well? **W** How many feet? **Approx 545**

FROM	TO	LITHOLOGIC LOG	FROM	TO	LITHOLOGIC LOG
0.0'	34'	Brown Plastic Clay, some Calcium Carbonate nodules			
34'	37.1	Gray Shale (Weathered)			

7 CONTRACTOR'S OR LANDOWNER'S CERTIFICATION: This water well was (1) **constructed** (2) reconstructed, or (3) plugged under my jurisdiction and was completed on (mo/day/year) **6/25/87** and this record is true to the best of my knowledge and belief. Kansas Water Well Contractor's License No. **361** This Water Well Record was completed on (mo/day/yr) **8-19-87** under the business name of **Cox-Beswick Irrigation Services** by (signature) **Francis Cox**