


1 LOCATION OF WATER WELL: Fraction NW 1/4 NW 1/4 SW 1/4 Section Number 260 Township Number T 25 S Range Number R 02 EN
County: Sedgwick
Distance and direction from nearest town or city street address of well if located within city?

3 miles S.E. of Furley, Kansas

2 WATER WELL OWNER: NIES
RR#, St. Address, Box #: 8808 N. 127th Street East
City, State, ZIP Code: Valley Center Kansas 67147
Board of Agriculture, Division of Water Resources
Application Number:

3 LOCATE WELL'S LOCATION WITH AN "X" IN SECTION BOX: 4 DEPTH OF COMPLETED WELL: 53.5 ft. ELEVATION: 1323.9

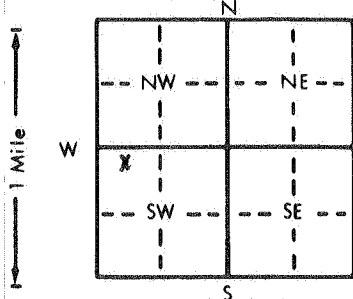

Depth(s) Groundwater Encountered 1. 39.7 ft. 2. ft. 3. ft.
WELL'S STATIC WATER LEVEL 39.7 ft. below land surface measured on mo/day/yr 4/9/82
NA Pump test data: Well water was ft. after hours pumping gpm
Est. Yield gpm: Well water was ft. after hours pumping gpm
Bore Hole Diameter 14 in. to 37.4 ft. and 7 1/8 in. to 53.5 ft.
WELL WATER TO BE USED AS: 5 Public water supply 8 Air conditioning 11 Injection well
1 Domestic 3 Feedlot 6 Oil field water supply 9 Dewatering 12 Other (Specify below)
2 Irrigation 4 Industrial 7 Lawn and garden only 10 Observation well Monitoring Well
Was a chemical/bacteriological sample submitted to Department? Yes No; If yes, mo/day/yr sample was submitted 3/23/82 4/9/82
Water Well Disinfected? Yes No

5 TYPE OF BLANK CASING USED: 5 Wrought iron 8 Concrete tile CASING JOINTS: Glued Clamped
1 Steel 3 RMP (SR) 6 Asbestos-Cement 9 Other (specify below) Welded
2 PVC 4 ABS 7 Fiberglass Threaded

Blank casing diameter 10 in. to 37.4 ft. Dia 4 in. to 46.0 ft. Dia in. to ft.
Casing height above land surface 1.9 ft. weight 10 in = 8.4 in = 2 lbs./ft. Wall thickness or gauge No. Sch. 40

TYPE OF SCREEN OR PERFORATION MATERIAL: 7 PVC 10 Asbestos-cement
1 Steel 3 Stainless steel 5 Fiberglass 8 RMP (SR) 11 Other (specify)
2 Brass 4 Galvanized steel 6 Concrete tile 9 ABS 12 None used (open hole)

SCREEN OR PERFORATION OPENINGS ARE: 5 Gauzed wrapped 8 Saw cut 11 None (open hole)
1 Continuous slot 3 Mill slot (0.010 in) 6 Wire wrapped 9 Drilled holes
2 Louvered shutter 4 Key punched 7 Torch cut 10 Other (specify)

SCREEN-PERFORATED INTERVALS: From 46.0 ft. to 50.1 ft. From ft. to ft.
From ft. to ft. From ft. to ft.
GRAVEL PACK INTERVALS: From 41.4 ft. to 53.5 ft. From ft. to ft.
From ft. to ft. From ft. to ft.

6 GROUT MATERIAL: 1 Neat cement 2 Cement grout 3 Bentonite 4 Other
Grout Intervals: From 0.0 ft. to 41.4 ft. From ft. to ft. From ft. to ft.

What is the nearest source of possible contamination: Evaporation Pond E-1 10 Livestock pens 14 Abandoned water well
1 Septic tank 4 Lateral lines 7 Pit privy 11 Fuel storage 15 Oil well/Gas well
2 Sewer lines 5 Cess pool 8 Sewage lagoon 12 Fertilizer storage 16 Other (specify below)
3 Watertight sewer lines 6 Seepage pit 9 Feedyard 13 Insecticide storage Haz. Waste Facility

Direction from well? S.E. How many feet? Approx. 200

FROM	TO	LITHOLOGIC LOG	FROM	TO	LITHOLOGIC LOG
0.0'	46'	Brown Plastic to highly plastic clay to weathered clay-shale with trace to some calcium carbonate nodules			
46'	53.5'	Bedrock Interbedded Gypsum and gray Shale			
		Note: Well riser lowered during site re-grading operations, Fall 1986 through Spring 1987			

7 CONTRACTOR'S OR LANDOWNER'S CERTIFICATION: This water well was (1) constructed, (2) reconstructed, or (3) plugged under my jurisdiction and was completed on (mo/day/year) 6/17/87 and this record is true to the best of my knowledge and belief. Kansas
Water Well Contractor's License No. 416 This Water Well Record was completed on (mo/day/yr) 9-8-87
under the business name of Terracon Consultants SC, Inc. by (signature)

INSTRUCTIONS: Use typewriter or ball point pen. PLEASE PRESS FIRMLY and PRINT clearly. Please fill in blanks, underline or circle the correct answers. Send top three copies to Kansas Department of Health and Environment, Bureau of Water Protection, Topeka, Kansas 66620-7320, Telephone: 913-862-9360. Send one to WATER WELL OWNER and retain one for your records.