


1 LOCATION OF WATER WELL: Fraction **SE 1/4 NE 1/4 SW 1/4** Section Number **26** Township Number **T 25 S** Range Number **R 02 EW**
 County: **Sedgwick**

Distance and direction from nearest town or city street address of well if located within city?
3 miles Southeast of Furley, Kansas

2 WATER WELL OWNER: **NIES**
 RR#, St. Address, Box #: **8808 North 127th Street East**
 City, State, ZIP Code: **Valley Center, Kansas 67147**
 Board of Agriculture, Division of Water Resources
 Application Number:

3 LOCATE WELL'S LOCATION WITH AN "X" IN SECTION BOX:

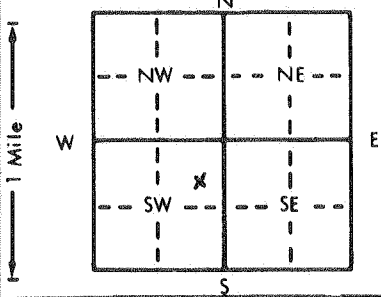

4 DEPTH OF COMPLETED WELL: **18.5** ft. ELEVATION: **1345.3** ft. MSL

Depth(s) Groundwater Encountered 1... **Dry During Drilling** ... ft. 3... .. ft.
 WELL'S STATIC WATER LEVEL **10.4** ft. below land surface measured on **1/10/84**
NA Pump test data: Well water was ... ft. after ... hours pumping ... gpm
 Est. Yield ... gpm: Well water was ... ft. after ... hours pumping ... gpm
 Bore Hole Diameter ... **6** in. to ... **18.5** ft., and ... in. to ... ft.
 WELL WATER TO BE USED AS: 5 Public water supply 8 Air conditioning 11 Injection well
 1 Domestic 3 Feedlot 6 Oil field water supply 9 Dewatering 12 **Other** (Specify below)
 2 Irrigation 4 Industrial 7 Lawn and garden only 10 Observation well **Monitoring Well**
 Was a chemical/bacteriological sample submitted to Department? Yes...... No......; If yes, mo/day/yr sample was submitted **1/10/84**
 Water Well Disinfected? Yes No

5 TYPE OF BLANK CASING USED: 5 Wrought iron 8 Concrete tile CASING JOINTS: Glued ... Clamped ...
 1 Steel 3 RMP (SR) 6 Asbestos-Cement 9 Other (specify below) Welded ...
 2 **PVC** 4 ABS 7 Fiberglass Threaded...

Blank casing diameter ... **2** in. to **12.8** ft., Dia ... in. to ... ft., Dia ... in. to ... ft.
 Casing height above land surface ... **2.2** ft. in, weight ... **0.70** lbs./ft. Wall thickness or gauge No. **Sch. 40**

TYPE OF SCREEN OR PERFORATION MATERIAL: 7 **PVC** 10 Asbestos-cement
 1 Steel 3 Stainless steel 5 Fiberglass 8 RMP (SR) 11 Other (specify) ...
 2 Brass 4 Galvanized steel 6 Concrete tile 9 ABS 12 None used (open hole)

SCREEN OR PERFORATION OPENINGS ARE: 5 Gauzed wrapped 8 Saw cut 11 None (open hole)
 1 Continuous slot 3 **Mill slot** 6 Wire wrapped 9 Drilled holes
 2 Louvered shutter 4 Key punched 7 Torch cut 10 Other (specify) ...

SCREEN-PERFORATED INTERVALS: From ... **12.8** ft. to ... **17.6** ft., From ... ft. to ... ft.
 GRAVEL PACK INTERVALS: From ... **12.3** ft. to ... **18.5** ft., From ... ft. to ... ft.

6 GROUT MATERIAL: 1 **Neat cement** 2 Cement grout 3 **Bentonite** 4 Other ...
 Grout Intervals: From ... **0.0** ft. to ... **12.3** ft., From ... ft. to ... ft., From ... ft. to ... ft.

What is the nearest source of possible contamination: **North Disp. Area** 10 Livestock pens 14 Abandoned water well
 1 Septic tank 4 Lateral lines 7 Pit privy 11 Fuel storage 15 Oil well/Gas well
 2 Sewer lines 5 Cess pool 8 Sewage lagoon 12 Fertilizer storage 16 **Other** (specify below)
 3 Watertight sewer lines 6 Seepage pit 9 Feedyard 13 Insecticide storage **Haz. Waste Facility**
 Direction from well? **WNW** How many feet? **Approx. 565**

FROM	TO	LITHOLOGIC LOG	FROM	TO	LITHOLOGIC LOG
0.0'	18.5'	Brown Plastic to highly Plastic clay, with some Calcium Carbonate nodules			
		Note: Well constructed on 10/27/83			
		Well log signed by			
		OK Terracon Consultants, Inc.			
		on 2/16/84			

7 CONTRACTOR'S OR LANDOWNER'S CERTIFICATION: This water well was (1) constructed, (2) reconstructed, or (3) **plugged** under my jurisdiction and was completed on (mo/day/year) ... **6/5/84** ... and this record is true to the best of my knowledge and belief. Kansas Water Well Contractor's License No. ... **416** ... This Water Well Record was completed on (mo/day/year) ... **9-7-84** ... under the business name of **Terracon Consultants, Inc.** by (signature) **[Signature]**