


LOCATION OF WATER WELL: Fraction NW 1/4 NE 1/4 SW 1/4 Section Number 26 Township Number T 25 S Range Number R 02 EW
 County: Sedgwick

Distance and direction from nearest town or city street address of well if located within city?
 Approximately 3 miles southeast of Furley, Kansas

WATER WELL OWNER: NIES
 RR#, St. Address, Box #: 8808 North 127th Street East
 City, State, ZIP Code: Valley Center, Kansas 67147
 Board of Agriculture, Division of Water Resources
 Application Number: 37,738

LOCATE WELL'S LOCATION WITH AN "X" IN SECTION BOX:
 DEPTH OF COMPLETED WELL: 42.6 ft. ELEVATION: 1331.5

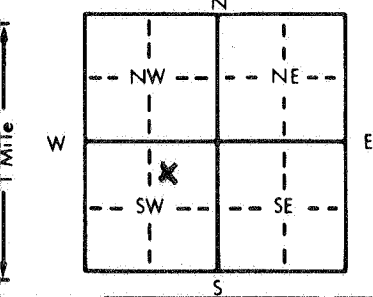

Depth(s) Groundwater Encountered 1. 29.1 ft. 2. ft. 3. ft.
 WELL'S STATIC WATER LEVEL 29.1 ft. below land surface measured on mo/day/yr 02/19/85
 NA Pump test data: Well water was ft. after hours pumping gpm
 Est. Yield gpm; Well water was ft. after hours pumping gpm
 Bore Hole Diameter 6 3/4 in. to 30.0 ft., and 6 in. to 42.6 ft.
 WELL WATER TO BE USED AS: 5 Public water supply 8 Air conditioning 11 Injection well
 1 Domestic 3 Feedlot 6 Oil field water supply 9 Dewatering (12 Other) (Specify below)
 2 Irrigation 4 Industrial 7 Lawn and garden only 10 Observation well Uncased Test Hole
 Was a chemical/bacteriological sample submitted to Department? Yes No ; If yes, mo/day/yr sample was submitted 02/19/85
 Water Well Disinfected? Yes No

TYPE OF BLANK CASING USED: NA
 1 Steel 3 RMP (SR) 5 Wrought iron 8 Concrete tile CASING JOINTS: Glued Clamped
 2 PVC 4 ABS 6 Asbestos-Cement 9 Other (specify below) Welded
 7 Fiberglass Threaded

Blank casing diameter in. to ft., Dia. in. to ft., Dia. in. to ft.
 Casing height above land surface in. weight lbs./ft. Wall thickness or gauge No.

TYPE OF SCREEN OR PERFORATION MATERIAL: NA
 1 Steel 3 Stainless steel 5 Fiberglass 8 RMP (SR) 10 Asbestos-cement
 2 Brass 4 Galvanized steel 6 Concrete tile 9 ABS 11 Other (specify)
 12 None used (open hole)

SCREEN OR PERFORATION OPENINGS ARE: NA
 1 Continuous slot 3 Mill slot 5 Gauzed wrapped 8 Saw cut 11 None (open hole)
 2 Louvered shutter 4 Key punched 6 Wire wrapped 9 Drilled holes
 7 Torch cut 10 Other (specify)

SCREEN-PERFORATED INTERVALS: From ft. to ft., From ft. to ft., From ft. to ft.
 GRAVEL PACK INTERVALS: From ft. to ft., From ft. to ft., From ft. to ft.

GROUT MATERIAL: 1 Neat cement 2 Cement grout 3 Bentonite 4 Other
 Grout intervals: From 42.6 ft. to 0.0 ft., From ft. to ft., From ft. to ft.

What is the nearest source of possible contamination: North Disposal Area Trench D-1 EXT.
 1 Septic tank 4 Lateral lines 7 Pit privy 10 Livestock pens 14 Abandoned water well
 2 Sewer lines 5 Cess pool 8 Sewage lagoon 11 Fuel storage 15 Oil well/Gas well
 3 Watertight sewer lines 6 Seepage pit 9 Feedyard 12 Fertilizer storage (16 Other) (specify below)
 13 Insecticide storage Haz. Waste Facility
 Direction from well? North How many feet? Approx. 10

FROM	TO	LITHOLOGIC LOG	FROM	TO	LITHOLOGIC LOG
0 feet	17 feet	Open hole to 5 ft. Dry/ moist, brown, highly plastic CLAY (CH) 1' cave in from 5 feet to 17 feet.			of original boring @ 40.6 feet depth (el 1333.5).
17 feet	30.0 feet	Wet, brown, highly plastic CLAY (CH). Boring re-drilled from 0 feet to 30.0 feet with 6 3/4 in. - O.D. hollow stem auger.			Boring re-drilled from 30.0 feet to 42.6 feet with 5 7/8 in. dia tri-cone roller bit and heavy bentonite/poble water drilling fluid.
30.0 feet	42.6 feet	Wet, brown, highly plastic CLAY (CH). Confirm bottom			Note: 6-in. dia. boring drilled by Standard Testing and Engineering Co., Oklahoma City, Oklahoma in Spring 1976 as part of the site investigation.

CONTRACTOR'S OR LANDOWNER'S CERTIFICATION: This boring was (1) constructed, (2) reconstructed, or (3) plugged under my jurisdiction and was completed on (mo/day/year) 02/20/85 and this record is true to the best of my knowledge and belief. Kansas Water Well Contractor's License No. 416 This Water Well Record was completed on (mo/day/yr) 4-15-85 under the business name of Terrason Consultants, Inc. by signature [Signature]

INSTRUCTIONS: Use typewriter or ball point pen, PLEASE PRESS FIRMLY and PRINT clearly. Please fill in blanks, underline or circle the correct answers. Send top three copies to Kansas Department of Health and Environment, Division of Environment, Environmental Geology Section, Topeka, KS 66620. Send one to WATER WELL OWNER and retain one for your records.