

Boring 264


1 LOCATION OF WATER WELL: Fraction NW 1/4 SW 1/4 SW 1/4 Section Number 26 Township Number T 25 S Range Number R 2 EW  
 County: SEDGWICK

Distance and direction from nearest town or city street address of well if located within city?

3 MILES S.E. OF FURLEN, KE.

2 WATER WELL OWNER: NIES  
 RR#, St. Address, Box #: 8308 N. 127th EAST.  
 City, State, ZIP Code: VALLEY CENTER, KE. 67147  
 Board of Agriculture, Division of Water Resources  
 Application Number:

3 LOCATE WELL'S LOCATION WITH AN "X" IN SECTION BOX:

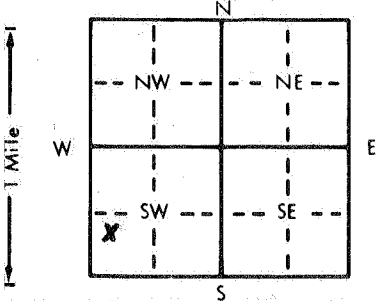

4 DEPTH OF COMPLETED WELL: 41.5 ft. ELEVATION: 1397.0  
 Depth(s) Groundwater Encountered: 1. DRY ft. 2. ft. 3. ft. 8. ft.  
 WELL'S STATIC WATER LEVEL: DRY ft. below land surface measured on mo/day/yr 3/2/82  
 NA Pump test data: Well water was ft. after hours pumping gpm  
 Est. Yield gpm Well water was ft. after hours pumping gpm  
 Bore Hole Diameter: 6 in. to 40.0 ft., and 2 in. to 41.5 ft.  
 WELL WATER TO BE USED AS:  
 1 Domestic 3 Feedlot 6 Oil field water supply 9 Dewatering 11 Injection well  
 2 Irrigation 4 Industrial 7 Lawn and garden only 10 Observation well 12 Other (Specify below) UNUSUAL TEST HOLE  
 Was a chemical/bacteriological sample submitted to Department? Yes No If yes, mo/day/yr sample was submitted Water Well Disinfected? Yes No

5 TYPE OF BLANK CASING USED: NA  
 1 Steel 3 RMP (SR) 5 Wrought iron 8 Concrete tile CASING JOINTS: Glued Clamped  
 2 PVC 4 ABS 6 Asbestos-Cement 9 Other (specify below) Welded  
 7 Fiberglass Threaded

Blank casing diameter in. to ft., Dia in. to ft., Dia in. to ft.  
 Casing height above land surface in., weight lbs./ft. Wall thickness or gauge No.

TYPE OF SCREEN OR PERFORATION MATERIAL: NA  
 1 Steel 3 Stainless steel 5 Fiberglass 7 PVC 10 Asbestos-cement  
 2 Brass 4 Galvanized steel 6 Concrete tile 8 RMP (SR) 11 Other (specify)  
 12 None used (open hole)

SCREEN OR PERFORATION OPENINGS ARE: NA  
 1 Continuous slot 3 Mill slot 5 Gauzed wrapped 8 Saw cut 11 None (open hole)  
 2 Louvered shutter 4 Key punched 6 Wire wrapped 9 Drilled holes  
 7 Torch cut 10 Other (specify)

SCREEN-PERFORATED INTERVALS: From ft. to ft., From ft. to ft., From ft. to ft.  
 GRAVEL PACK INTERVALS: From ft. to ft., From ft. to ft., From ft. to ft.

6 GROUT MATERIAL: 1 Neat cement 2 Cement grout 3 Bentonite 4 Other  
 Grout Intervals: From 3.0 ft. to 41.5 ft., From ft. to ft., From ft. to ft.

What is the nearest source of possible contamination: DISPOSAL TRENCH D-32  
 1 Septic tank 4 Lateral lines 7 Pit privy 10 Livestock pens 14 Abandoned water well  
 2 Sewer lines 5 Cess pool 8 Sewage lagoon 11 Fuel storage 15 Oil well/Gas well  
 3 Watertight sewer lines 6 Seepage pit 9 Feedyard 12 Fertilizer storage 16 Other (specify below) HAZARDOUS FACILITY  
 Direction from well? NE How many feet? APPROX. 460

| FROM      | TO         | LITHOLOGIC LOG  | FROM | TO | LITHOLOGIC LOG |
|-----------|------------|---|------|----|----------------|
| 0.0 (ft.) | 41.5 (ft.) | BROWN, PLASTIC TO HIGHLY PLASTIC CLAY TO WEATHERED CLAY-SHALE, WITH TRACE TO SOME CALCIUM CARBONATE NODULES |      |    |                |

7 CONTRACTOR'S OR LANDOWNER'S CERTIFICATION: This water well was (1) constructed, (2) reconstructed, or (3) plugged under my jurisdiction and was completed on (mo/day/year) 3/2/82 and this record is true to the best of my knowledge and belief. Kansas Water Well Contractor's License No. 416 This Water Well Record was completed on (mo/day/yr) 5/21/82 under the business name of TERRACON CONSULTANTS INC. by (signature)

INSTRUCTIONS: Use typewriter or ball point pen, PLEASE PRESS FIRMLY and PRINT clearly. Please fill in blanks, underline or circle the correct answers. Send top three copies to Kansas Department of Health and Environment, Division of Environment, Environmental Geology Section, Topeka, KS 66620. Send one to WATER WELL OWNER and retain one for your records.