


1 LOCATION OF WATER WELL: Fraction NW 1/4 SW 1/4 SW 1/4 Section Number 26 Township Number T 25 S Range Number R 02 E
 County: Sedgwick

Distance and direction from nearest town or city street address of well if located within city?
Approximately 3 miles southeast of Furley, Kansas

2 WATER WELL OWNER: NIES
 RR#, St. Address, Box #: 8808 North 127th Street East
 City, State, ZIP Code: Valley Center, Kansas 67147
 Board of Agriculture, Division of Water Resources
 Application Number:

3 LOCATE WELL'S LOCATION WITH AN "X" IN SECTION BOX: X in SW corner of section
 4 DEPTH OF COMPLETED WELL: 73.9 ft. ELEVATION: 1325.2
 Depth(s) Groundwater Encountered 1. est. 59.5 ft. 2. _____ ft. 3. _____ ft.

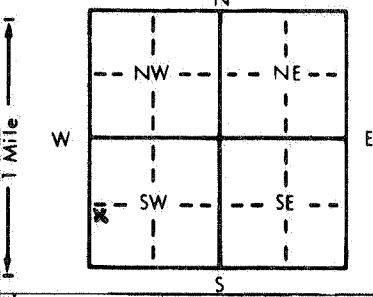

WELL'S STATIC WATER LEVEL ... 69.4 ft. below land surface measured on mo/day/yr 08/07/85
NA Pump test data: Well water was _____ ft. after _____ hours pumping _____ gpm
 Est. Yield _____ gpm: Well water was _____ ft. after _____ hours pumping _____ gpm
 Bore Hole Diameter ... 14 in. to 59.1 ft., and 7 7/8 in. to 73.9 ft.
 WELL WATER TO BE USED AS: 5 Public water supply 8 Air conditioning 11 Injection well
 1 Domestic 3 Feedlot 6 Oil field water supply 9 Dewatering 12 Other (Specify below)
 2 Irrigation 4 Industrial 7 Lawn and garden only 10 Observation well Monitoring Well
 Was a chemical/bacteriological sample submitted to Department? Yes _____ No If yes, mo/day/yr sample was submitted
 Water Well Disinfected? Yes _____ No

5 TYPE OF BLANK CASING USED: 1 Steel 3 RMP (SR) 5 Wrought iron 8 Concrete tile CASING JOINTS: Glued _____ Clamped _____
2 PVC 4 ABS 6 Asbestos-Cement 9 Other (specify below) Welded _____
 7 Fiberglass Threaded
 Blank casing diameter ... 10 in. to 59.1 ft. Dia. 4 in. to 68.2 ft. Dia. _____ in. to _____ ft.
 Casing height above land surface ... 2.0 ft weight 10 in. = 8; 4 in. = 2 lbs./ft. Wall thickness or gauge No. Sch. 40

TYPE OF SCREEN OR PERFORATION MATERIAL: 1 Steel 3 Stainless steel 5 Fiberglass 8 RMP (SR) 10 Asbestos-cement
 2 Brass 4 Galvanized steel 6 Concrete tile 9 ABS 11 Other (specify) _____
 12 None used (open hole)

SCREEN OR PERFORATION OPENINGS ARE: 1 Continuous slot 3 Mill slot 0.010 inch 6 Wire wrapped 8 Saw cut 11 None (open hole)
 2 Louvered shutter 4 Key punched 7 Torch cut 10 Other (specify) _____

SCREEN-PERFORATED INTERVALS: From 68.2 ft. to 72.9 ft. From _____ ft. to _____ ft.
 GRAVEL PACK INTERVALS: From 61.5 ft. to 73.9 ft. From _____ ft. to _____ ft.

6 GROUT MATERIAL: 1 Neat cement 2 Cement grout 3 Bentonite 4 Other _____
 Grout Intervals: From 61.5 ft. to 0.0 ft. From _____ ft. to _____ ft.
 What is the nearest source of possible contamination: South Disp. Area 10 Livestock pens 14 Abandoned water well
 1 Septic tank 4 Lateral lines 7 Pit privy 11 Fuel storage 15 Oil well/Gas well
 2 Sewer lines 5 Cess pool 8 Sewage lagoon 12 Fertilizer storage 16 Other (specify below)
 3 Watertight sewer lines 6 Seepage pit 9 Feedyard 13 Insecticide storage Haz. Waste Facility
 Direction from well? ENE How many feet? Approx. 640

FROM	TO	LITHOLOGIC LOG	FROM	TO	LITHOLOGIC LOG
0.0 feet	59.5 feet	Brown, plastic to highly plastic CLAY to weathered CLAY-SHALE with trace to some calcium carbonate nodules			Notes: (1) Well boring drilled with air rotary rig, tri-cone roller bits, and minor amount of potable water to remove cuttings. (2) Well static water level measured the day after developing the well by bailing.
59.5 feet	73.9 feet	Hard, white GYPSUM BEDROCK			

7 CONTRACTOR'S OR LANDOWNER'S CERTIFICATION: This water well was (1) constructed, (2) reconstructed, or (3) plugged under my jurisdiction and was completed on (mo/day/year) 06/28/85 and this record is true to the best of my knowledge and belief. Kansas Water Well Contractor's License No. 361 This Water Well Record was completed on (mo/day/yr) 8-29-85 under the business name of Cox-Beswick Irrigation Service, Inc. by (signature) Francis Cox
 INSTRUCTIONS: Use typewriter or ball point pen, PLEASE PRESS FIRMLY and PRINT clearly. Please fill in blanks, underline or circle the correct answers. Send top three copies to Kansas Department of Health and Environment, Division of Environment, Environmental Geology Section, Topeka, KS 66620. Send one to WATER WELL OWNER and retain one for your records.