A-214

WATER WELL RECORD Form WWC-5 KSA 82a-1212

1 LOCATION OF WATER WELL: County: SEDGWICK | Fraction: NW ¼ NE ¼ SW ¼ | Section Number: 26 | Township Number: T 25 S | Range Number: R 2 (E)W

Distance and direction from nearest town or city street address of well if located within city?
3 MILES S.E. OF FURLEY, KS.

2 WATER WELL OWNER: NIES
RR#, St. Address, Box # : 8808 N. 127TH EAST
City, State, ZIP Code : VALLEY CENTER, KS. 67147

Board of Agriculture, Division of Water Resources
Application Number:

3 LOCATE WELL'S LOCATION WITH AN "X" IN SECTION BOX:

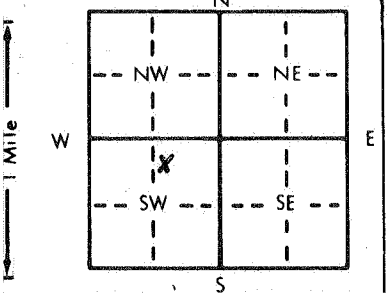

4 DEPTH OF COMPLETED WELL 40.3 ft. ELEVATION: 1385.2
Depth(s) Groundwater Encountered 1. DRY ft. 2. ~~ft.~~ 3. ~~ft.~~
WELL'S STATIC WATER LEVEL DRY ft. below land surface measured on mo/day/yr 3/9/82
NA Pump test data: Well water was ~~ft.~~ after ~~hours~~ pumping ~~gpm~~
Est. Yield ~~gpm~~: Well water was ~~ft.~~ after ~~hours~~ pumping ~~gpm~~
Bore Hole Diameter 6 in. to 40.3 ft., ~~and in. to ft.~~
WELL WATER TO BE USED AS: 1 Domestic 2 Irrigation 3 Feedlot 4 Industrial 5 Public water supply 6 Oil field water supply 7 Lawn and garden only 8 Air conditioning 9 Dewatering 10 Observation well 11 Injection well 12 Other (Specify below) MONITORING WELL
Was a chemical/~~bacteriological~~ sample submitted to Department? Yes ~~No~~ ✓; If yes, mo/day/yr sample was submitted
Water Well Disinfected? Yes ~~No~~ ✓

5 TYPE OF BLANK CASING USED: 1 Steel 2 PVC 3 RMP (SR) 4 ABS 5 Wrought iron 6 Asbestos-Cement 7 Fiberglass 8 Concrete tile 9 Other (specify below)
CASING JOINTS: Glued ~~Clamped~~ Welded ✓ Threaded
Blank casing diameter 2 in. to 29.3 ft., ~~Dia. in. to ft., Dia. in. to ft.~~
Casing height above land surface 1.9 ft. ~~in.~~, weight 0.70 lbs./ft. Wall thickness or gauge No. SCH. 40

TYPE OF SCREEN OR PERFORATION MATERIAL: 1 Steel 2 Brass 3 Stainless steel 4 Galvanized steel 5 Fiberglass 6 Concrete tile 7 PVC 8 RMP (SR) 9 ABS 10 Asbestos-cement 11 Other (specify) 12 None used (open hole)

SCREEN OR PERFORATION OPENINGS ARE: 1 Continuous slot 2 Louvered shutter 3 Mill slot 4 Key punched 5 Gauzed wrapped 6 Wire wrapped 7 Torch cut 8 Saw cut 9 Drilled holes 10 Other (specify) 11 None (open hole)

SCREEN-PERFORATED INTERVALS: From 29.3 ft. to 39.3 ft., ~~From ft. to ft., From ft. to ft.~~
~~From ft. to ft., From ft. to ft.~~

GRAVEL PACK INTERVALS: From 16.2 ft. to 40.3 ft., ~~From ft. to ft., From ft. to ft.~~
~~From ft. to ft., From ft. to ft.~~

6 GROUT MATERIAL: 1 Neat cement 2 Cement grout 3 Bentonite 4 Other
Grout Intervals: From 0.0 ft. to 16.2 ft., ~~From ft. to ft., From ft. to ft.~~

What is the nearest source of possible contamination: DRUM DISPOSAL TRENCHES 2B
1 Septic tank 2 Sewer lines 3 Watertight sewer lines 4 Lateral lines 5 Cess pool 6 Seepage pit 7 Pit privy 8 Sewage lagoon 9 Feedyard 10 Livestock pens 11 Fuel storage 12 Fertilizer storage 13 Insecticide storage 14 Abandoned water well 15 Oil well/Gas well 16 Other (specify below) HAZ WASTE FACILITY
Direction from well? SOUTH How many feet? 35 APPROX.

FROM	TO	LITHOLOGIC LOG	FROM	TO	LITHOLOGIC LOG
0.0 (FT)	40.3 (FT)	BROWN PLASTIC TO MOIST PLASTIC CLAY TO WEATHERED CLAY-SHALE WITH TRACE TO SOME CALCIUM CARBONATE NODULES			

7 CONTRACTOR'S OR LANDOWNER'S CERTIFICATION: This water well was (1) constructed, (2) reconstructed, or (3) plugged under my jurisdiction and was completed on (mo/day/year) 2/25/82 and this record is true to the best of my knowledge and belief. Kansas Water Well Contractor's License No. 416 This Water Well Record was completed on (mo/day/yr) 5/19/82
under the business name of TERRACON CONSULTANTS INC. by (signature) [signature]

INSTRUCTIONS: Use typewriter or ball point pen, *PLEASE PRESS FIRMLY* and *PRINT* clearly. Please fill in blanks, underline or circle the correct answers. Send top three copies to Kansas Department of Health and Environment, Division of Environment, Environmental Geology Section, Topeka, KS 66620. Send one to WATER WELL OWNER and retain one for your records.