


LOCATION OF WATER WELL: County: SEDGWICK Fraction: NW 1/4 NE 1/4 SW 1/4 Section Number: 26 Township Number: T 25 S Range Number: R 2 EW

Distance and direction from nearest town or city street address of well if located within city? 3 MILES S.E. OF FURLEY, KS.

WATER WELL OWNER: NIES RR#, St. Address, Box #: 8808 N. 127th EAST City, State, ZIP Code: VALLEY CENTER, KS. 67147 Board of Agriculture, Division of Water Resources Application Number:

LOCATE WELL'S LOCATION WITH AN "X" IN SECTION BOX: DEPTH OF COMPLETED WELL: 53.0 ft. ELEVATION: 1380.9

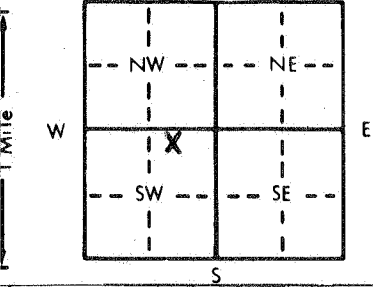

Depth(s) Groundwater Encountered: 1. 47.7 ft. 2. 0 ft. 0. ft.
 WELL'S STATIC WATER LEVEL: 47.7 ft. below land surface measured on mo/day/yr 3/9/82
 Pump test data: Well water was NA ft. after 0 hours pumping 0 gpm
 Est. Yield 0 gpm Well water was NA ft. after 0 hours pumping 0 gpm
 Bore Hole Diameter: 12 1/4 in. to 40.2 ft. and 7 7/8 in. to 53.0 ft.
 WELL WATER TO BE USED AS:
 5 Public water supply 8 Air conditioning 11 Injection well
 1 Domestic 3 Feedlot 6 Oil field water supply 9 Dewatering 12 Other (Specify below) MONITORING WELL
 2 Irrigation 4 Industrial 7 Lawn and garden only 10 Observation well
 Was a chemical/bacteriological sample submitted to Department? Yes No If yes, mo/day/yr sample was submitted 3/8 + 15/82 Water Well Disinfected? Yes No

TYPE OF BLANK CASING USED:
 1 Steel PVC 3 RMP (SR) 4 ABS 5 Wrought iron 6 Asbestos-Cement 7 Fiberglass 8 Concrete tile 9 Other (specify below) CASING JOINTS: Glued Clamped Welded Threaded

Blank casing diameter: 10 in. to 40.2 ft. Dia. 4 in. to 47.5 ft. Dia. 0 in. to 0 ft. Dia. 0 in. to 0 ft. Dia.
 Casing height above land surface: 3.4 FT. weight 10 IN = 8; 4 IN = 2 lbs./ft. Wall thickness or gauge No. SCH. 40

TYPE OF SCREEN OR PERFORATION MATERIAL:
 1 Steel 3 Stainless steel 5 Fiberglass 7 PVC 10 Asbestos-cement
 2 Brass 4 Galvanized steel 6 Concrete tile 8 RMP (SR) 11 Other (specify)
 9 ABS 12 None used (open hole)

SCREEN OR PERFORATION OPENINGS ARE:
 1 Continuous slot 3 Mill slot 5 Gauzed wrapped 8 Saw cut 11 None (open hole)
 2 Louvered shutter 4 Key punched 6 Wire wrapped 9 Drilled holes
 7 Torch cut 10 Other (specify)

SCREEN-PERFORATED INTERVALS: From 47.5 ft. to 51.6 ft. From 0 ft. to 0 ft. From 0 ft. to 0 ft. From 0 ft. to 0 ft.
 GRAVEL PACK INTERVALS: From 44.9 ft. to 53.0 ft. From 0 ft. to 0 ft. From 0 ft. to 0 ft. From 0 ft. to 0 ft.

GROUT MATERIAL: 1 Neat cement 2 Cement grout 3 Bentonite 4 Other
 Grout Intervals: From 0.0 ft. to 44.9 ft. From 0 ft. to 0 ft. From 0 ft. to 0 ft. From 0 ft. to 0 ft.

What is the nearest source of possible contamination: DRAIN TRENCH DISPOSAL 0-2C TRENCH 10 Livestock pens 14 Abandoned water well
 1 Septic tank 4 Lateral lines 7 Pit privy 11 Fuel storage 15 Oil well/Gas well
 2 Sewer lines 5 Cess pool 8 Sewage lagoon 12 Fertilizer storage 16 Other (specify below) Haz. WASTE FACILITY
 3 Watertight sewer lines 6 Seepage pit 9 Feedyard 13 Insecticide storage

Direction from well? SOUTH How many feet? 145 APPROX.

FROM	TO	LITHOLOGIC LOG	FROM	TO	LITHOLOGIC LOG
<u>0.0</u>	<u>~47</u>	<u>BROWN PLASTIC TO HIGHLY PLASTIC DAY TO WEATHERED CLAY SHALE WITH TRACE TO SOME CALCIUM CARBONATE NODULES</u>			
<u>~47</u>	<u>53.0</u>	<u>BEDROCK - INTERBEDDED GYPSUM AND GRAY SHALE</u>			

CONTRACTOR'S OR LANDOWNER'S CERTIFICATION: This water well was (1) constructed (2) reconstructed, or (3) plugged under my jurisdiction and was completed on (mo/day/year) 3/23/82 and this record is true to the best of my knowledge and belief. Kansas Water Well Contractor's License No. 361 This Water Well Record was completed on (mo/day/yr) 5/18/82 under the business name of COX-BESWICK IRRIGATION SERVICES, INC. by signature Francis Cox

INSTRUCTIONS: Use typewriter or ball point pen, PLEASE PRESS FIRMLY and PRINT clearly. Please fill in blanks, underline or circle the correct answers. Send top three copies to Kansas Department of Health and Environment, Division of Environment, Environmental Geology Section, Topeka, KS 66620. Send one to WATER WELL OWNER and retain one for your records.