


1 LOCATION OF WATER WELL: Fraction SW 1/4 NW 1/4 SW 1/4 Section Number 26 Township Number T 25 S Range Number R 2 E/W

Distance and direction from nearest town or city street address of well if located within city? 3 miles S.E. of Furley Ks.

2 WATER WELL OWNER: NIES RR#, St. Address, Box #: 8808 N. 127th East City, State, ZIP Code: VALLEY CENTER, Ks. 67147 Board of Agriculture, Division of Water Resources Application Number:

3 LOCATE WELL'S LOCATION WITH AN "X" IN SECTION BOX: DEPTH OF COMPLETED WELL: 62.6 ft. ELEVATION: 1393.2

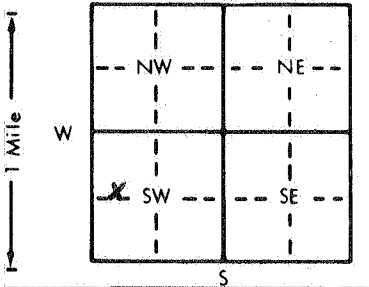

Depth(s) Groundwater Encountered: 56.5 ft. WELL'S STATIC WATER LEVEL: 56.5 ft. below land surface measured on mo/day/yr 3/9/82

5 TYPE OF BLANK CASING USED: 1 Steel 2 PVC 3 RMP (SR) 4 ABS 5 Wrought iron 6 Asbestos-Cement 7 Fiberglass 8 Concrete tile 9 Other (specify below) 10 Asbestos-cement 11 Other (specify) 12 None used (open hole)

Blank casing diameter: 10 in. to 53.2 ft. Dia 4 in. to 61.8 ft. Dia Casing height above land surface: 2.2 ft. weight 10 in. = 8; 4 in. = 2 lbs./ft. Wall thickness or gauge No. 30440

TYPE OF SCREEN OR PERFORATION MATERIAL: 1 Steel 2 Brass 3 Stainless steel 4 Galvanized steel 5 Fiberglass 6 Concrete tile 7 PVC 8 RMP (SR) 9 ABS 10 Asbestos-cement 11 Other (specify) 12 None used (open hole)

SCREEN OR PERFORATION OPENINGS ARE: 1 Continuous slot 2 Louvered shutter 3 Mill slot 4 Key punched 5 Gauzed wrapped 6 Wire wrapped 7 Torch cut 8 Saw cut 9 Drilled holes 10 Other (specify) 11 None (open hole)

SCREEN-PERFORATED INTERVALS: From 61.8 ft. to 65.9 ft. GRAVEL PACK INTERVALS: From 56.8 ft. to 67.6 ft.

6 GROUT MATERIAL: 1 Neat cement 2 Cement grout 3 Bentonite 4 Other Grout Intervals: From 0.0 ft. to 56.8 ft.

What is the nearest source of possible contamination? Drum Disposal Trench D-20 10 Livestock pens 11 Fuel storage 12 Fertilizer storage 13 Insecticide storage 14 Abandoned water well 15 Oil well/Gas well 16 Other (specify below) HAZ WASTE FACILITY

Direction from well? N/E How many feet? 45 APPROV.

Table with columns: FROM, TO, LITHOLOGIC LOG, FROM, TO, LITHOLOGIC LOG. Contains handwritten entries for 0.0 to 56.8 ft and 56.8 to 67.6 ft.

7 CONTRACTOR'S OR LANDOWNER'S CERTIFICATION: This water well was (1) constructed (2) reconstructed, or (3) plugged under my jurisdiction and was completed on (mo/day/year) 3/3/82 and this record is true to the best of my knowledge and belief. Kansas Water Well Contractor's License No. 361 This Water Well Record was completed on (mo/day/yr) 5/19/82 under the business name of Beswick Irrigation Service Inc. by (signature) F. Mannix