


LOCATION OF WATER WELL: Fraction SW 1/4 SW 1/4 SW 1/4 Section Number 26 Township Number T 25 S Range Number R 2 EW

Distance and direction from nearest town or city street address of well if located within city? 3 miles S.E. of FLASH, KS

WATER WELL OWNER: NIES RR#, St. Address, Box #: 8808 N. 127th East City, State, ZIP Code: VALLEY CENTER, KS. 67477 Board of Agriculture, Division of Water Resources Application Number:

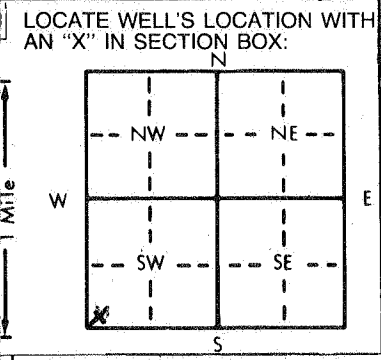

LOCATE WELL'S LOCATION WITH AN 'X' IN SECTION BOX: DEPTH OF COMPLETED WELL: 51.9 ft. ELEVATION: 1394.9 ft. WELL'S STATIC WATER LEVEL: 46.3 ft. below land surface measured on 4/1/82. Pump test data: Well water was NA ft. after hours pumping gpm. Est. Yield gpm: Well water was NA ft. after hours pumping gpm. Bore Hole Diameter: 6 in. to 51.9 ft., and in to ft. WELL WATER TO BE USED AS: 5 Public water supply 8 Air conditioning 11 Injection well 1 Domestic 3 Feedlot 6 Oil field water supply 9 Dewatering 12 Other (Specify below) 2 Irrigation 4 Industrial 7 Lawn and garden only 10 Observation well MONITORING Well Was a chemical/bacteriological sample submitted to Department? Yes No; If yes, mo/day/yr sample was submitted 3/31/82 4/1/82 Water Well Disinfected? Yes No

TYPE OF BLANK CASING USED: 1 Steel 3 RMP (SR) 5 Wrought iron 8 Concrete tile CASING JOINTS: Glued Clamped 2 PVC 4 ABS 6 Asbestos-Cement 9 Other (specify below) Welded 7 Fiberglass Threaded. TYPE OF SCREEN OR PERFORATION MATERIAL: 1 Steel 3 Stainless steel 5 Fiberglass 8 RMP (SR) 10 Asbestos-cement 2 Brass 4 Galvanized steel 6 Concrete tile 9 ABS 11 Other (specify) 12 None used (open hole) SCREEN OR PERFORATION OPENINGS ARE: 1 Continuous slot 3 Mill slot 4 Key punched 5 Gauzed wrapped 6 Wire wrapped 7 Torch cut 8 Saw cut 9 Drilled holes 10 Other (specify) 11 None (open hole) SCREEN-PERFORATED INTERVALS: From 40.9 ft. to 50.9 ft. GRAVEL PACK INTERVALS: From 19.9 ft. to 51.9 ft.

GROUT MATERIAL: 1 Neat cement 2 Cement grout 3 Bentonite 4 Other Grout Intervals: From 0.0 ft. to 19.9 ft. What is the nearest source of possible contamination: 1 Septic tank 4 Lateral lines 7 Pit privy 10 Livestock pens 14 Abandoned water well 2 Sewer lines 5 Cess pool 8 Sewage lagoon 11 Fuel storage 15 Oil well/Gas well 3 Watertight sewer lines 6 Seepage pit 9 Feedyard 12 Fertilizer storage 16 Other (specify below) 13 Insecticide storage Direction from well? SSW How many feet? approx. 1000

LITHOLOGIC LOG table with columns FROM, TO, LITHOLOGIC LOG, FROM, TO, LITHOLOGIC LOG. Entry: 0.0 ft. to 51.9 ft. Brown Plastic to Heavy Plastic Clay to weathered clay shale with trace to some calcium carbonate nodules.

CONTRACTOR'S OR LANDOWNER'S CERTIFICATION: This water well was (1) constructed (2) reconstructed, or (3) plugged under my jurisdiction and was completed on (mo/day/year) 3/29/82 and this record is true to the best of my knowledge and belief. Kansas Water Well Contractor's License No. 416 This Water Well Record was completed on (me/day/yr) 5/20/82 under the business name of TEADON CONSULTANTS INC. by (signature) INSTRUCTIONS: Use typewriter or ball point pen, PLEASE PRESS FIRMLY and PRINT clearly. Please fill in blanks, underline or circle the correct answers. Send top three copies to Kansas Department of Health and Environment, Division of Environment, Environmental Geology Section, Topeka, KS 66620. Send one to WATER WELL OWNER and retain one for your records.