

LOCATION OF WATER WELL	Fraction	Section Number	Township Number	Range Number
County: <b>SEDGWICK</b>	<b>SW 1/4 SW 1/4 SW 1/4</b>	<b>26</b>	<b>T 25 S</b>	<b>R 2 EW</b>

Distance and direction from nearest town or city? **APPROXIMATELY 10 MILES NE OF WICHITA** Street address of well if located within city?

WATER WELL OWNER: **KIES**  
 P.O. Box # **745**  
 City, State, ZIP Code: **WICHITA KANSAS 67201** **12-D**  
 Board of Agriculture, Division of Water Resources  
 Application Number:

DEPTH OF COMPLETED WELL: **63.5** ft. Bore Hole Diameter: **4** in. to **63.5** ft. and . . . . . in. to . . . . . ft.

Well Water to be used as:

5 Public water supply	8 Air conditioning	11 Injection well
1 Domestic	3 Feedlot	6 Oil field water supply
2 Irrigation	4 Industrial	7 Lawn and garden only
		<b>10 Observation well</b>
		12 Other (Specify below)

Well's static water level: **48.8** ft. below land surface measured on **JULY** month **13** day **1981** year

Pump Test Data: Well water was . . . . . ft. after . . . . . hours pumping. . . . . gpm  
 Est. Yield gpm: Well water was . . . . . ft. after . . . . . hours pumping . . . . . gpm

TYPE OF BLANK CASING USED:

1 Steel	3 RMP (SR)	5 Wrought iron	8 Concrete tile	Casing Joints: Glued <input checked="" type="checkbox"/> Clamped . . . . .
<b>2 PVC</b>	4 ABS	6 Asbestos-Cement	9 Other (specify below)	Welded . . . . .
		7 Fiberglass		Threaded . . . . .

Blank casing dia: **1** in. to **53.5** ft., Dia . . . . . in. to . . . . . ft., Dia . . . . . in. to . . . . . ft.

Casing height above land surface: **22** in., weight . . . . . lbs./ft. Wall thickness or gauge No. **SCHEDULE 40**

TYPE OF SCREEN OR PERFORATION MATERIAL:

1 Steel	3 Stainless steel	5 Fiberglass	8 RMP (SR)	11 Other (specify) . . . . .
2 Brass	4 Galvanized steel	6 Concrete tile	9 ABS	12 None used (open hole)

Screen or Perforation Openings Are:

1 Continuous slot	3 Mill slot	5 Gauzed wrapped	<b>8 Saw cut</b>	11 None (open hole)
2 Louvered shutter	4 Key punched	6 Wire wrapped	9 Drilled holes	
		7 Torch cut	10 Other (specify) . . . . .	

Screen-Perforation Dia: **1** in. to **63.5** ft., Dia . . . . . in. to . . . . . ft., Dia . . . . . in. to . . . . . ft.

Screen-Perforated Intervals: From **53.5** ft. to **63.5** ft., From . . . . . ft. to . . . . . ft., From . . . . . ft. to . . . . . ft.

Gravel Pack Intervals: From **46.5** ft. to **63.5** ft., From . . . . . ft. to . . . . . ft., From . . . . . ft. to . . . . . ft.

GROUT MATERIAL: **1 Neat cement** 2 Cement grout **3 Bentonite** 4 Other . . . . .  
 Grouted Intervals: From **0** ft. to **43.5** ft., From **43.5** ft. to **46.5** ft., From . . . . . ft. to . . . . . ft.

What is the nearest source of possible contamination:

1 Septic tank	4 Cess pool	<b>7 Sewage lagoon</b>	10 Fuel storage	14 Abandoned water well
2 Sewer lines	5 Seepage pit	8 Feed yard	11 Fertilizer storage	15 Oil well/Gas well
3 Lateral lines	6 Pit privy	9 Livestock pens	12 Insecticide storage	16 Other (specify below)
			13 Watertight sewer lines	

Direction from well: **NORTH** How many feet: **+1600** ? Water Well Disinfected? Yes . . . . . No


Was a chemical/bacteriological sample submitted to Department? Yes . . . . . No  If yes, date sample was submitted . . . . . month . . . . . day . . . . . year: Pump Installed? Yes . . . . . No

If Yes: Pump Manufacturer's name . . . . . Model No. . . . . HP . . . . . Volts . . . . .

Depth of Pump Intake . . . . . ft. Pumps Capacity rated at . . . . . gal./min.

Type of pump: 1 Submersible 2 Turbine 3 Jet 4 Centrifugal 5 Reciprocating 6 Other

CONTRACTOR'S OR LANDOWNER'S CERTIFICATION: This water well was **(1) constructed** (2) reconstructed, or (3) plugged under my jurisdiction and was completed on **JULY** month **10** day **1981** year and this record is true to the best of my knowledge and belief. Kansas Water Well Contractor's License No. **399**  
 This Water Well Record was completed on **JULY** month **14** day **1981** year under the business name of **WOODWARD-CLYDE CONSULTANTS** by (signature) *Richard L. Meloy*

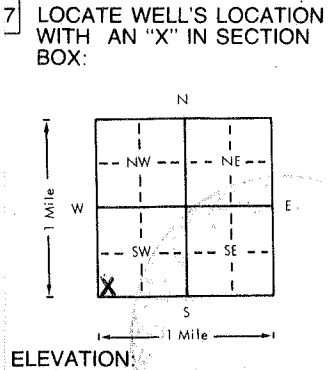

FROM	TO	LITHOLOGIC LOG	FROM	TO	LITHOLOGIC LOG
0	84	BLACK, CLAYEY TOPSOIL	25	64	LIGHT GRAY TO YELLOW
8	19	YELLOW-BROWN (W/GREEN, RED, GRAY MOTILES) SILTY CLAY WEATHERED SHALE, SOME CARBONATE			GRAY SANDY CLAY AND SILTY CLAY CARBONATE BECOMES ABUNDANT BELOW 50 FT.
19	25	ABUNDANT RED MOTILES IN YELLOW-BROWN CLAY. SOME CARBONATE CRYSTALS, NODULES			

ELEVATION: Depth(s) Groundwater Encountered 1. **49** ft. 2. . . . . ft. 3. . . . . ft. 4. . . . . ft. (Use a second sheet if needed)

INSTRUCTIONS: Use typewriter or ball point pen, please press firmly and PRINT clearly. Please fill in blanks, underline or circle the correct answers. Send top three copies to Kansas Department of Health and Environment, Division of Environment, Water Well Contractors, Topeka, KS 66620. Send one to WATER WELL OWNER and retain one for your records.