


1 LOCATION OF WATER WELL: Fraction SE 1/4 NW 1/4 SW 1/4 Section Number 26 Township Number T 25 S Range Number R 2 EW

Distance and direction from nearest town or city street address of well if located within city?

3 MILES S.E. OF FURLEY, KS

2 WATER WELL OWNER: NIES RR#, St. Address, Box #: 8808 N. 127th EAST City, State, ZIP Code: VALLEY CENTER, KS- 67147 Board of Agriculture, Division of Water Resources Application Number:

3 LOCATE WELL'S LOCATION WITH AN "X" IN SECTION BOX: DEPTH OF COMPLETED WELL: 40.4 ft. ELEVATION: 1385.6

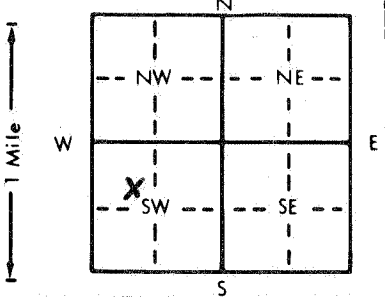

Depth(s) Groundwater Encountered 1. 37.6 ft. 2. ft. 3. ft. WELL'S STATIC WATER LEVEL 37.6 ft. below land surface measured on mo/day/yr 3/9/82

5 TYPE OF BLANK CASING USED: 1 Steel 2 PVC 3 RMP (SR) 4 ABS 5 Wrought iron 6 Asbestos-Cement 7 Fiberglass 8 Concrete tile 9 Other (specify below) CASING JOINTS: Glued Clamped Welded Threaded

Blank casing diameter 2 in. to 29.4 ft. Dia. Casing height above land surface 2.4 ft. weight 0.70 lbs./ft. Wall thickness or gauge No. SCH 40

TYPE OF SCREEN OR PERFORATION MATERIAL: 1 Steel 2 Brass 3 Stainless steel 4 Galvanized steel 5 Fiberglass 6 Concrete tile 7 PVC 8 RMP (SR) 9 ABS 10 Asbestos-cement 11 Other (specify) 12 None used (open hole)

SCREEN OR PERFORATION OPENINGS ARE: 1 Continuous slot 2 Louvered shutter 3 Mill slot 4 Key punched 5 Gauzed wrapped 6 Wire wrapped 7 Torch cut 8 Saw cut 9 Drilled holes 10 Other (specify) 11 None (open hole)

SCREEN-PERFORATED INTERVALS: From 29.4 ft. to 39.4 ft. GRAVEL PACK INTERVALS: From 12.6 ft. to 40.4 ft.

6 GROUT MATERIAL: 1 Neat cement 2 Cement grout 3 Bentonite 4 Other Grout intervals: From 0.0 ft. to 12.6 ft. What is the nearest source of possible contamination: Drum Disposal Trench D-28

Direction from well? SOUTH How many feet? 20 APPROX.

LITHOLOGIC LOG table with columns FROM, TO, and LITHOLOGIC LOG. Entry: 0.0 (FT) to 40.4 (FT) Brown Plastic to Heavy Plastic Clay to weathered clay shale with trace to some calcium carbonate nodules.

7 CONTRACTOR'S OR LANDOWNER'S CERTIFICATION: This water well was (1) constructed, (2) reconstructed, or (3) plugged under my jurisdiction and was completed on (mo/day/year) 2/18/82 and this record is true to the best of my knowledge and belief. Kansas Water Well Contractor's License No. 416 This Water Well Record was completed on (mo/day/yr) 5/18/82 under the business name of TERRARON CONSULTANTS INC by (signature)

INSTRUCTIONS: Use typewriter or ball point pen, PLEASE PRESS FIRMLY and PRINT clearly. Please fill in blanks, underline or circle the correct answers. Send top three copies to Kansas Department of Health and Environment, Division of Environment, Environmental Geology Section, Topeka, KS 66620. Send one to WATER WELL OWNER and retain one for your records.