

KOHE BORING 8A


Distance and direction from nearest town or city street address of well if located within city?

3 mile S.E. OF FURRY, Ks.

Board of Agriculture, Division of Water Resources

Application Number:

LOCATE WELL'S LOCATION WITH AN "X" IN SECTION BOX:

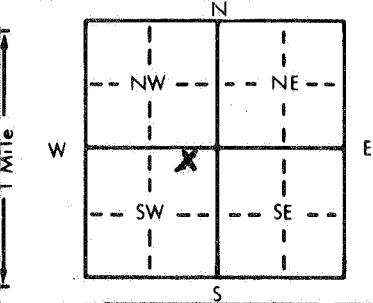

4 DEPTH OF COMPLETED WELL..... 49 ft. ELEVATION:..... 1361.6
 Depth(s) Groundwater Encountered 1. 28 ft. 2. ft. 3. ft.
 WELL'S STATIC WATER LEVEL 28 ft. below land surface measured on mo/day/yr 1/27/82
 NA Pump test data: Well water was ft. after hours pumping gpm
 Est. Yield gpm; Well water was ft. after hours pumping gpm
 Bore Hole Diameter 4 in. to 49 ft., and in. to ft.
 WELL WATER TO BE USED AS: 5 Public water supply 8 Air conditioning 11 Injection well
 1 Domestic 3 Feedlot 6 Oil field water supply 9 Dewatering 12 Other (Specify below)
 2 Irrigation 4 Industrial 7 Lawn and garden only 10 Observation well WAS NOT ST. NAE
 Was a chemical/bacteriological sample submitted to Department? Yes.....No.....✓; If yes, mo/day/yr sample was sub
 mitted Water Well Disinfected? Yes No ✓

TYPE OF BLANK CASING USED: 11A

TYPE OF SCREEN OR PERFORATION MATERIAL: 1/4 7 PVC 10 Asbestos-cement

1 Steel 3 Stainless steel

SCREEN OR PERFORATION OPENINGS ARE:

GREEN-PERFORATED INTERVALS: From.

GROUT MATERIAL: 1 Neat cement

What is the nearest source of possible contamination?

direction from well? *WSc*

FROM	TO	LITHO

CONTRACTOR'S OR LANDOWNER'S CERTIFICATE

Water Well Contractor's License No. 41

INSTRUCTIONS: Use typewriter or ball point pen, PLEASE PRESS FIRMLY and PRINT clearly. Please fill in blanks, underline or circle the correct answers. Send top three copies to Kansas Department of Health and Environment, Division of Environment, Environmental Geology Section, Topeka, KS 66620. Send one to WATER WELL OWNER and retain one for your records.