


LOCATION OF WATER WELL: Fraction SE 1/4 NE 1/4 SW 1/4 Section Number 26 Township Number T 25 S Range Number R 2 E/W

Distance and direction from nearest town or city street address of well if located within city? 3 miles S.E. of FURLEY, KS.

WATER WELL OWNER: NILES RR#, St. Address, Box #: 8908 N. 127th East City, State, ZIP Code: VALLEY CENTER, KS. 67147 Board of Agriculture, Division of Water Resources Application Number:

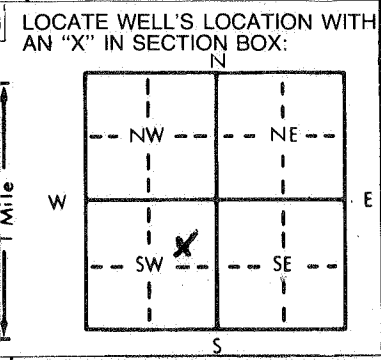

LOCATE WELL'S LOCATION WITH AN 'X' IN SECTION BOX: DEPTH OF COMPLETED WELL: 32.0 ft. ELEVATION: 1368.8 ft. WELL'S STATIC WATER LEVEL: 15.9\* ft. below land surface measured on mo/day/yr 3/12/82

TYPE OF BLANK CASING USED: NA 1 Steel 3 RMP (SR) 2 PVC 4 ABS 5 Wrought iron 6 Asbestos-Cement 7 Fiberglass 8 Concrete tile 9 Other (specify below) 10 Observation well CASING JOINTS: Glued Clamped Welded Threaded

Blank casing diameter: in. to ft., Dia. in. to ft., Dia. in. to ft. Casing height above land surface: in., weight lbs./ft. Wall thickness or gauge No.

TYPE OF SCREEN OR PERFORATION MATERIAL: NA 1 Steel 3 Stainless steel 5 Fiberglass 8 RMP (SR) 10 Asbestos-cement 11 Other (specify) 2 Brass 4 Galvanized steel 6 Concrete tile 9 ABS 12 None used (open hole)

SCREEN OR PERFORATION OPENINGS ARE: NA 1 Continuous slot 3 Mill slot 5 Gauzed wrapped 8 Saw cut 11 None (open hole) 2 Louvered shutter 4 Key punched 6 Wire wrapped 9 Drilled holes 7 Torch cut 10 Other (specify)

SCREEN-PERFORATED INTERVALS: From ft. to ft., From ft. to ft., From ft. to ft. GRAVEL PACK INTERVALS: From ft. to ft., From ft. to ft., From ft. to ft.

GROUT MATERIAL: Neat cement 2 Cement grout 3 Bentonite 4 Other Grout Intervals: From 0.0 ft. to 32.0 ft., From ft. to ft., From ft. to ft.

What is the nearest source of possible contamination: Former ROB STO. AREA 10 Livestock pens 14 Abandoned water well 1 Septic tank 4 Lateral lines 7 Pit privy 11 Fuel storage 15 Oil well/Gas well 2 Sewer lines 5 Cess pool 8 Sewage lagoon 12 Fertilizer storage 16 Other (specify below) 3 Watertight sewer lines 6 Seepage pit 9 Feedyard 13 Insecticide storage HAZ. WASTE FACILITY

Direction from well? SW How many feet? APPROX. 90

Table with columns: FROM, TO, LITHOLOGIC LOG, FROM, TO, LITHOLOGIC LOG. Entry: (0.0) (32.0) BROWN, PLASTIC TO HIGHLY PLASTIC CLAY TO WEATHERED CLAY-SHALE, WITH SOME CALCIUM CARBONATE PLATE + NODULES

\* WATER LEVEL MEASUREMENT QUESTIONABLE AS TEST HOLE CAVED AT 17.5 FT DEPTH CONTRACTOR'S OR LANDOWNER'S CERTIFICATION: This water well was (1) constructed, (2) reconstructed, or (3) plugged under my jurisdiction and was completed on (mo/day/year) 4/2/82 and this record is true to the best of my knowledge and belief. Kansas Water Well Contractor's License No. 416 This Water Well Record was completed on (mo/day/year) 5/24/82 under the business name of TERRACON CONSULTANTS INC. by (signature)