


Distance and direction from nearest town or city street address of well if located within city?

3 Miles Southeast of Furley, Kansas

3 LOCATE WELL'S LOCATION WITH AN "X" IN SECTION BOX: 4 DEPTH OF COMPLETED WELL: 31.6 ft. ELEVATION: 1345.0 ft MSL

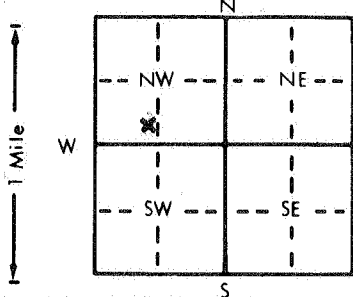

4) DEPTH OF COMPLETED WELL: 31.6 ft. ELEVATION: 1345.0 ft MSL
 Depth(s) Groundwater Encountered 1. DRY ft. 2. _____ ft. 3. _____ ft.
 WELL'S STATIC WATER LEVEL DRY + below land surface measured on mo/day/yr 11/29/83
NA Pump test data: Well water was _____ ft. after _____ hours pumping _____ gpm
 Est. Yield _____ gpm Well water was _____ ft. after _____ hours pumping _____ gpm
 Bore Hole Diameter: 6 in. to 31.6 ft., and _____ in. to _____ ft.
 WELL WATER TO BE USED AS:
 1 Domestic 3 Feedlot 6 Oil field water supply 8 Air conditioning 11 Injection well
 2 Irrigation 4 Industrial 7 Lawn and garden only 9 Dewatering 12 Other (Specify below)
10 Observation well monitoring Well
 Was a chemical/bacteriological sample submitted to Department? Yes NA No V If yes, mo/day/yr sample was submitted _____
 Water Well Disinfected? Yes _____ No V

5	TYPE OF BLANK CASING USED:	5 Wrought iron	8 Concrete tile	CASING JOINTS: Glued	Clamped
	1 Steel	3 RMP (SR)	6 Asbestos-Cement	9 Other (specify below)	Welded
	2 <u>PVC</u>	4 ABS	7 Fiberglass		Threaded. <input checked="" type="checkbox"/>

Blank casing diameter 2 in. to 21.4 ft. Dia _____ in. to _____ ft. Dia _____ in. to _____ ft.
Casing height above land surface 2.6 ft weight 0.70 lbs./ft. Wall thickness or gauge No. Sch. 40

TYPE OF SCREEN OR PERFORATION MATERIAL:

1 Steel	3 Stainless steel	5 Fiberglass	7 <u>PVC</u>	10 Asbestos-cement
2 Brass	4 Galvanized steel	6 Concrete tile	8 RMP (SR)	11 Other (specify)
			9 ABS	12 None used (open hole)

SCREEN OR PERFORATION OPENINGS ARE:

1 Continuous slot	3 <u>Mill slot</u>	5 Gauzed wrapped	8 Saw cut	11 None (open hole)
2 Louvered shutter	4 Key punched	6 Wire wrapped	9 Drilled holes	
		7 Torch cut	10 Other (specify)	

SCREEN-PERFORATED INTERVALS: From 21.4 ft. to 31.0 ft. From _____ ft. to _____ ft.
 _____ ft. to _____ ft. From _____ ft. to _____ ft.
 GRAVEL PACK INTERVALS: From 12.0 ft. to 31.6 ft. From _____ ft. to _____ ft.
 _____ ft. to _____ ft. From _____ ft. to _____ ft.

6 GROUT MATERIAL: 1 Neat cement 2 Cement grout 3 Bentonite 4 Other
Grout Intervals: From 0.0 ft. to 12.0 ft. From ft. to ft. From ft. to ft.

What is the nearest source of possible contamination: *North Disp. Area*

1 Septic tank	4 Lateral lines	7 Pit privy	10 Livestock pens	14 Abandoned water well
2 Sewer lines	5 Cess pool	8 Sewage lagoon	11 Fuel storage	15 Oil well/Gas well
3 Watertight sewer lines	6 Seepage pit	9 Feedyard	12 Fertilizer storage	16 <u>Other</u> (specify below)

Direction from well? *SSE*

How many feet? *Approx. 600*

Haz. Waste Facility

[illegible]

7) CONTRACTOR'S OR LANDOWNER'S CERTIFICATION: This water well was (1) constructed, (2) reconstructed, or (3) plugged under my jurisdiction and was completed on (mo/day/year) 11/16/83 and this record is true to the best of my knowledge and belief. Kansas Water Well Contractor's License No. 416 This Water Well Record was completed on (mo/day/yr) 12-18-81 under the business name of Terracon Consultants, Inc. by (signature) [Signature]

INSTRUCTIONS: Use typewriter or ball point pen, PLEASE PRESS FIRMLY and PRINT clearly. Please fill in blanks, underline or circle the correct answers. Send top three copies to Kansas Department of Health and Environment, Division of Environment, Environmental Geology Section, Topeka, KS 66620. Send one to WATER WELL OWNER and retain one for your records.