


1 LOCATION OF WATER WELL: Fraction SE 1/4 SW 1/4 NW 1/4 Section Number 26 Township Number T 25 S Range Number R 2 E
 County: SEDGWICK
 Distance and direction from nearest town or city street address of well if located within city?

3 miles S.E. OF FURLEY, Ks.

2 WATER WELL OWNER: NIES
 RR#, St. Address, Box #: 8808 N. 127TH EAST
 City, State, ZIP Code: VALLEY CENTER, KS 67147
 Board of Agriculture, Division of Water Resources
 Application Number:

3 LOCATE WELL'S LOCATION WITH AN "X" IN SECTION BOX:

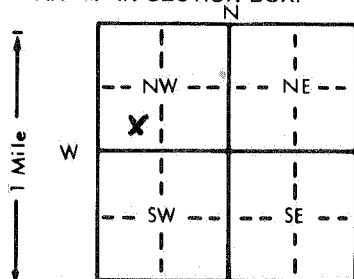

4 DEPTH OF COMPLETED WELL: 59.0 ft. ELEVATION: 1384.6

Depth(s) Groundwater Encountered 51.0 ft. 2 51.0 ft. 3 51.0 ft.

WELL'S STATIC WATER LEVEL 51.0 ft. below land surface measured on mo/day/yr 3/11/82

NA Pump test data: Well water was NA ft. after NA hours pumping NA gpm

Est. Yield NA gpm: Well water was NA ft. after NA hours pumping NA gpm

Bore Hole Diameter 14 in. to 44.6 ft., and 27/8 in. to 59.0 ft.

WELL WATER TO BE USED AS: 5 Public water supply 8 Air conditioning 11 Injection well

1 Domestic 3 Feedlot 6 Oil field water supply 9 Dewatering 12 Other (Specify below)

2 Irrigation 4 Industrial 7 Lawn and garden only 10 Observation well MONITORING WELL

Was a chemical/bacteriological sample submitted to Department? Yes ✓ No ✓ If yes, mo/day/yr sample was submitted

3/16+24/82 Water Well Disinfected? Yes ✓ No ✓

5 TYPE OF BLANK CASING USED:

1 Steel 3 RMP (SR) 5 Wrought iron 8 Concrete tile CASING JOINTS: Glued ✓ Clamped ✓

2 PVC 4 ABS 6 Asbestos-Cement 9 Other (specify below) Welded ✓

7 Fiberglass Threaded ✓

Blank casing diameter 10 in. to 44.6 ft. Dia 4 in. to 53.5 ft. Dia NA in. to NA ft.

Casing height above land surface 1.6 ft. weight 10 in. = 8.5 lbs./ft. Wall thickness or gauge No. SCH 40

TYPE OF SCREEN OR PERFORATION MATERIAL:

1 Steel 3 Stainless steel 5 Fiberglass 8 RMP (SR) 10 Asbestos-cement

2 Brass 4 Galvanized steel 6 Concrete tile 9 ABS 11 Other (specify)

12 None used (open hole)

SCREEN OR PERFORATION OPENINGS ARE:

1 Continuous slot 3 Mill slot 5 Gauzed wrapped 8 Saw cut 11 None (open hole)

2 Louvered shutter 4 Key punched 6 Wire wrapped 9 Drilled holes

7 Torch cut 10 Other (specify)

SCREEN-PERFORATED INTERVALS:

From 53.5 ft. to 57.3 ft. From 57.3 ft. to 59.0 ft.

GRAVEL PACK INTERVALS:

From 48.6 ft. to 59.0 ft. From 59.0 ft. to NA ft.

6 GROUT MATERIAL:

1 Neat cement 2 Cement grout 3 Bentonite 4 Other

Grout Intervals: From 0.0 ft. to 48.6 ft. From 48.6 ft. to 59.0 ft. From 59.0 ft. to NA ft.

What is the nearest source of possible contamination: EVAPORATION POND E2

1 Septic tank 4 Lateral lines 7 Pit privy 10 Livestock pens 14 Abandoned water well

2 Sewer lines 5 Cess pool 8 Sewage lagoon 11 Fuel storage 15 Oil well/Gas well

3 Watertight sewer lines 6 Seepage pit 9 Feedyard 12 Fertilizer storage 16 Other (specify below)

HAZ. WASTE FACILITY

Direction from well? SOUTH How many feet? APPROX 530

FROM TO LITHOLOGIC LOG

0.0 PT. NA PT. ~51 PT. BROWN PLASTIC TO HEAVY

PT. PT. PLASTIC CLAY TO WEATHERED CLAY -

SHALE WITH TRACE TO SOME

CALCIUM CARBONATE NODULES

~51 PT. 59.0 PT. BEDROCK-INTERBEDDED GYPSEUM

PT. PT. AND GRAY SHALE

FROM TO LITHOLOGIC LOG

FROM TO LITHOLOGIC LOG

7 CONTRACTOR'S OR LANDOWNER'S CERTIFICATION: This water well was (1) constructed (2) reconstructed, or (3) plugged under my jurisdiction and was completed on (mo/day/year) 3/5/82 and this record is true to the best of my knowledge and belief. Kansas

Water Well Contractor's License No. 361 This Water Well Record was completed on (mo/day/yr) 5/19/82

under the business name of G.V. BESWICK IRRIGATION SERVICE, INC. by (signature) James Cox

INSTRUCTIONS: Use typewriter or ball point pen, PLEASE PRESS FIRMLY and PRINT clearly. Please fill in blanks, underline or circle the correct answers. Send top

three copies to Kansas Department of Health and Environment, Division of Environment, Environmental Geology Section, Topeka, KS 66620. Send one to WATER WELL

OWNER and retain one for your records.