


LOCATION OF WATER WELL: Fraction SW 1/4 NE 1/4 SW 1/4 Section Number 26 Township Number T 25 S Range Number R 02 E  
County: Sedgwick

Distance and direction from nearest town or city street address of well if located within city?  
3 miles Southeast of Furley, Kansas

WATER WELL OWNER: NIES  
RR#, St. Address, Box #: 8808 North 127th Street East  
City, State, ZIP Code: Valley Center, Kansas 67147  
Board of Agriculture, Division of Water Resources  
Application Number:

LOCATE WELL'S LOCATION WITH AN "X" IN SECTION BOX: DEPTH OF COMPLETED WELL: 23.5 ft. ELEVATION: 1350.2 ft MSL

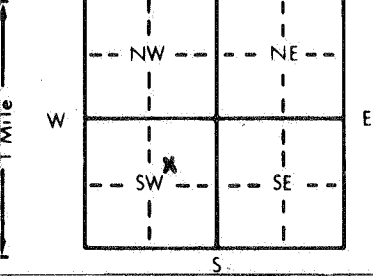

Depth(s) Groundwater Encountered 1. 18.2 ft. 2. . . . . ft. 3. . . . . ft.  
WELL'S STATIC WATER LEVEL NA ft. below land surface measured on mo/day/yr 11/21/83  
Pump test data: Well water was . . . . . ft. after . . . . . hours pumping . . . . . gpm  
Est. Yield . . . . . gpm: Well water was . . . . . ft. after . . . . . hours pumping . . . . . gpm  
Bore Hole Diameter . . . . . in. to . . . . . ft., and . . . . . in. to . . . . . ft.  
WELL WATER TO BE USED AS:  
1 Domestic 3 Feedlot 6 Oil field water supply 9 Dewatering 12 Other (Specify below)  
2 Irrigation 4 Industrial 7 Lawn and garden only 10 Observation well Monitoring Well  
Was a chemical/bacteriological sample submitted to Department? Yes . . . . . No . . . . . ; If yes, mo/day/yr sample was submitted . . . . .  
Water Well Disinfected? Yes . . . . . No . . . . .

TYPE OF BLANK CASING USED:  
1 Steel 3 RMP (SR) 5 Wrought iron 8 Concrete tile CASING JOINTS: Glued . . . . . Clamped . . . . .  
2 PVC 4 ABS 6 Asbestos-Cement 9 Other (specify below) Welded . . . . .  
Blank casing diameter 5 in. to . . . . . ft., Dia . . . . . in. to . . . . . ft., Dia . . . . . in. to . . . . . ft.  
Casing height above land surface . . . . . in., weight . . . . . lbs./ft. Wall thickness or gauge No. . . . .

TYPE OF SCREEN OR PERFORATION MATERIAL:  
1 Steel 3 Stainless steel 5 Fiberglass 8 RMP (SR) 10 Asbestos-cement  
2 Brass 4 Galvanized steel 6 Concrete tile 9 ABS 12 None used (open hole)

SCREEN OR PERFORATION OPENINGS ARE:  
1 Continuous slot 3 Mill slot 5 Gauzed wrapped 8 Saw cut 11 None (open hole)  
2 Louvered shutter 4 Key punched 6 Wire wrapped 9 Drilled holes  
7 Torch cut 10 Other (specify) . . . . .

SCREEN-PERFORATED INTERVALS: From . . . . . ft. to . . . . . ft., From . . . . . ft. to . . . . . ft.  
GRAVEL PACK INTERVALS: From . . . . . ft. to . . . . . ft., From . . . . . ft. to . . . . . ft.

GROUT MATERIAL: 1 Neat cement 2 Cement grout 3 Bentonite 4 Other . . . . .  
Grout Intervals: From 0.0 ft. to 23.5 ft., From . . . . . ft. to . . . . . ft.

What is the nearest source of possible contamination: Disp. Cell No. 1A 10 Livestock pens 14 Abandoned water well  
1 Septic tank 4 Lateral lines 7 Pit privy 11 Fuel storage 15 Oil well/Gas well  
2 Sewer lines 5 Cess pool 8 Sewage lagoon 12 Fertilizer storage 16 Other (specify below)  
3 Watertight sewer lines 6 Seepage pit 9 Feedyard 13 Insecticide storage Haz. Waste Facility

Direction from well? Southwest How many feet? Approx. 330

FROM	TO	LITHOLOGIC LOG	FROM	TO	LITHOLOGIC LOG

CONTRACTOR'S OR LANDOWNER'S CERTIFICATION: This water well was (1) constructed, (2) reconstructed, or (3) plugged under my jurisdiction and was completed on (mo/day/year) 11/21/83 and this record is true to the best of my knowledge and belief. Kansas Water Well Contractor's License No. 416. This Water Well Record was completed on (mo/day/year) 11/21/83 under the business name of Terracon Consultants, Inc. by signature [Signature]

INSTRUCTIONS: Use typewriter or ball point pen, PLEASE PRESS FIRMLY and PRINT clearly. Please fill in blanks, underline or circle the correct answers. Send top three copies to Kansas Department of Health and Environment, Division of Environment, Environmental Geology Section, Topeka, KS 66620. Send one to WATER WELL OWNER and retain one for your records.