


Monitoring Well MW-6

LOCATION OF WATER WELL: Fraction SE 1/4 NE 1/4 SW 1/4 Section Number 26 Township Number T 25 S Range Number R 02 EW

Distance and direction from nearest town or city street address of well if located within city? 3 miles southeast of Furley, Kansas

WATER WELL OWNER: NIES 8808 North 127th Street East Valley Center, Kansas 67147 Board of Agriculture, Division of Water Resource Application Number:

LOCATE WELL'S LOCATION WITH AN "X" IN SECTION BOX: DEPTH OF COMPLETED WELL: 35 ft. ELEVATION: 1341.4 ft MSL

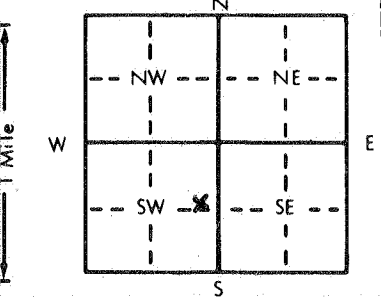

Depth(s) Groundwater Encountered 1. ft. 2. ft. 3. ft. WELL'S STATIC WATER LEVEL 25.2 ft. below land surface measured on mo/day/yr 11/18/83 NA Pump test data: Well water was ... ft. after ... hours pumping ... gpm Est. Yield ... gpm: Well water was ... ft. after ... hours pumping ... gpm Bore Hole Diameter 11 in. to 35 ft., and ... in. to ... ft. WELL WATER TO BE USED AS: 5 Public water supply 8 Air conditioning 11 Injection well 1 Domestic 3 Feedlot 6 Oil field water supply 9 Dewatering 12 Other (Specify below) 2 Irrigation 4 Industrial 7 Lawn and garden only 10 Observation well Monitoring Well Was a chemical/bacteriological sample submitted to Department? Yes ... No ...; If yes, mo/day/yr sample was submitted

TYPE OF BLANK CASING USED: 1 Steel 3 RMP (SR) 5 Wrought iron 8 Concrete tile CASING JOINTS: Glued ... Clamped ... 2 PVC 4 ABS 6 Asbestos-Cement 9 Other (specify below) Welded ... Threaded ... 7 Fiberglass

Blank casing diameter 5 in. to 20 ft., Dia ... in. to ... ft., Dia ... in. to ... ft., Dia ... in. to ... ft. Casing height above land surface 18 in., weight 2.28 lbs./ft. Wall thickness or gauge No. 0.214 in.

TYPE OF SCREEN OR PERFORATION MATERIAL: 1 Steel 3 Stainless steel 5 Fiberglass 8 RMP (SR) 10 Asbestos-cement 2 Brass 4 Galvanized steel 6 Concrete tile 9 ABS 11 Other (specify) ... 12 None used (open hole)

SCREEN OR PERFORATION OPENINGS ARE: 1 Continuous slot 3 Mill slot 5 Gauzed wrapped 8 Saw cut 11 None (open hole) 2 Louvered shutter 4 Key punched 6 Wire wrapped 9 Drilled holes 7 Torch cut 10 Other (specify) ...

SCREEN-PERFORATED INTERVALS: From 20 ft. to 35 ft., From ... ft. to ... ft., From ... ft. to ... ft., From ... ft. to ... ft.

GRAVEL PACK INTERVALS: From 10 ft. to 35 ft., From ... ft. to ... ft., From ... ft. to ... ft., From ... ft. to ... ft.

GROUT MATERIAL: 1 Neat cement 2 Cement grout 3 Bentonite 4 Other Grout Intervals: From 0.0 ft. to 35 ft., From ... ft. to ... ft., From ... ft. to ... ft., From ... ft. to ... ft.

What is the nearest source of possible contamination: Disp. Cell No. 1A 10 Livestock pens 14 Abandoned water well 1 Septic tank 4 Lateral lines 7 Pit privy 11 Fuel storage 15 Oil well/Gas well 2 Sewer lines 5 Cess pool 8 Sewage lagoon 12 Fertilizer storage 16 Other (specify below) 3 Watertight sewer lines 6 Seepage pit 9 Feedyard 13 Insecticide storage Haz. Waste Facility

Direction from well? WNW How many feet? Approx. 800

LITHOLOGIC LOG table with columns FROM, TO, and LITHOLOGIC LOG. Entries include 0ft to 2ft Topsoil and 2ft to 35ft Clay - yellowish tan, sticky. Includes a note about log copying and a signature from Wichita, Kansas.

CONTRACTOR'S OR LANDOWNER'S CERTIFICATION: This water well was (1) constructed, (2) reconstructed, or (3) plugged under my jurisdiction and was completed on (mo/day/year) 11/18/83 and this record is true to the best of my knowledge and belief. Kansas Water Well Contractor's License No. 416 This Water Well Record was completed on (mo/day/yr) 2-10-84 under the business name of Terracon Consultants, Inc. by (signature)

INSTRUCTIONS: Use typewriter or ball point pen, PLEASE PRESS FIRMLY and PRINT clearly. Please fill in blanks, underline or circle the correct answers. Send top three copies to Kansas Department of Health and Environment, Division of Environment, Environmental Geology Section, Topeka, KS 66620. Send one to WATER WELL OWNER and retain one for your records.