


LOCATION OF WATER WELL: Fraction NE 1/4 NW 1/4 SW 1/4 Section Number 26 Township Number T 25 S Range Number R 2

Distance and direction from nearest town or city street address of well if located within city?

3 miles S.E. of Freen, Ks

WATER WELL OWNER: NIES RR#, St. Address, Box #: 8908 N. 127th East City, State, ZIP Code: VALLEY CENTER, KS 67147 Board of Agriculture, Division of Water Resources Application Number:

LOCATE WELL'S LOCATION WITH AN "X" IN SECTION BOX:

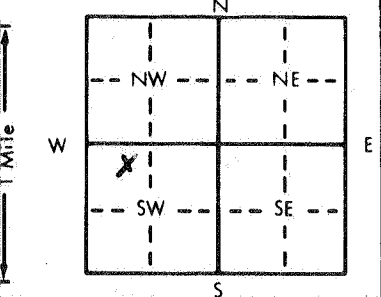

DEPTH OF COMPLETED WELL: 43.9 ft. ELEVATION: 1388.9

Depth(s) Groundwater Encountered: 1. 37.2 ft. 2. ft. 3. ft. WELL'S STATIC WATER LEVEL: 37.2 ft. below land surface measured on mo/day/yr: 4/1/82

NA Pump test data: Well water was ft. after hours pumping gpm Est. Yield gpm Well water was ft. after hours pumping gpm Bore Hole Diameter: 6 in. to 43.9 ft. and in. to ft.

WELL WATER TO BE USED AS: 1 Domestic 2 Irrigation 3 Feedlot 4 Industrial 5 Public water supply 6 Oil field water supply 7 Lawn and garden only 8 Air conditioning 9 Dewatering 10 Observation well 11 Injection well 12 Other (Specify below) MONITORING WELL

Was a chemical/bacteriological sample submitted to Department? Yes [X] No [] If yes, mo/day/yr sample was submitted 3/30/82 4/1/82 Water Well Disinfected? Yes [] No [X]

TYPE OF BLANK CASING USED: 1 Steel 2 PVC 3 RMP (SR) 4 ABS 5 Wrought iron 6 Asbestos-Cement 7 Fiberglass 8 Concrete tile 9 Other (specify below) CASING JOINTS: Glued [] Clamped [] Welded [] Threaded [X]

Blank casing diameter: 2 in. to 32.9 ft. Dia. in. to ft. Dia. in. to ft. Casing height above land surface: 2.2 ft. weight: 0.70 lbs./ft. Wall thickness or gauge No. SCH. 40

TYPE OF SCREEN OR PERFORATION MATERIAL: 1 Steel 2 Brass 3 Stainless steel 4 Galvanized steel 5 Fiberglass 6 Concrete tile 7 PVC 8 RMP (SR) 9 ABS 10 Asbestos-cement 11 Other (specify) 12 None used (open hole)

SCREEN OR PERFORATION OPENINGS ARE: 1 Continuous slot 2 Louvered shutter 3 Mill slot 4 Key punched 5 Gauzed wrapped 6 Wire wrapped 7 Torch cut 8 Saw cut 9 Drilled holes 10 Other (specify) 11 None (open hole)

SCREEN-PERFORATED INTERVALS: From 32.9 ft. to 42.9 ft. From ft. to ft. From ft. to ft. From ft. to ft.

GRAVEL PACK INTERVALS: From 13.9 ft. to 43.9 ft. From ft. to ft. From ft. to ft. From ft. to ft.

GROUT MATERIAL: 1 Neat cement 2 Cement grout 3 Bentonite 4 Other Grout Intervals: From 0.0 ft. to 13.9 ft. From ft. to ft. From ft. to ft. From ft. to ft.

What is the nearest source of possible contamination: 1 Septic tank 2 Sewer lines 3 Watertight sewer lines 4 Lateral lines 5 Cess pool 6 Seepage pit 7 Pit privy 8 Sewage lagoon 9 Feedyard 10 Livestock pens 11 Fuel storage 12 Fertilizer storage 13 Insecticide storage 14 Abandoned water well 15 Oil well/Gas well 16 Other (specify below) HAZ. WASTE FACILITY

Direction from well? WEST AND EAST AND Treatment Pond T-2 How many feet? APPROX. 80

Table with columns: FROM, TO, LITHOLOGIC LOG, FROM, TO, LITHOLOGIC LOG. Row 1: 0.0 FT., 43.9 FT., BROWN PLASTIC TO HEAVY PLASTIC CLAY TO WEATHERED CLAY SHALE WITH TRACE TO SOME CALCIUM CARBONATE NODULES

CONTRACTOR'S OR LANDOWNER'S CERTIFICATION: This water well was (1) constructed (2) reconstructed, or (3) plugged under my jurisdiction and was completed on (mo/day/year) 3/23/82 and this record is true to the best of my knowledge and belief. Kansas Water Well Contractor's License No. 416 This Water Well Record was completed on (mo/day/yr) 5/20/82 under the business name of TERRACON CONSULTANTS INC by (signature)

INSTRUCTIONS: Use typewriter or ball point pen, PLEASE PRESS FIRMLY and PRINT clearly. Please fill in blanks, underline or circle the correct answers. Send top three copies to Kansas Department of Health and Environment, Division of Environment, Environmental Geology Section, Topeka, KS 66620. Send one to WATER WELL OWNER and retain one for your records.