


1 LOCATION OF WATER WELL: Fraction **NE 1/4 SW 1/4 SW 1/4** Section Number **26** Township Number **T 25 S** Range Number **R 02 EW**  
 County: **Sedgwick**  
 Distance and direction from nearest town or city street address of well if located within city?

**3 miles Southeast of Furley, Kansas**

2 WATER WELL OWNER: **NIES**  
 RR#, St. Address, Box #: **8808 North 127th Street East** Board of Agriculture, Division of Water Resources  
 City, State, ZIP Code: **Valley Center, Kansas 67147** Application Number:

3 LOCATE WELL'S LOCATION WITH AN "X" IN SECTION BOX:

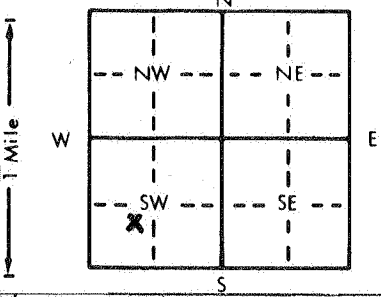

4 DEPTH OF COMPLETED WELL: **58.5** ft. ELEVATION: **1325.4 MSL**

Depth(s) Groundwater Encountered 1. **45.8** ft. 2. \_\_\_\_\_ ft. 3. \_\_\_\_\_ ft.  
 WELL'S STATIC WATER LEVEL **45.8** ft. below land surface measured on mo/day/yr **07/29/83**  
 Pump test data: Well water was \_\_\_\_\_ ft. after \_\_\_\_\_ hours pumping \_\_\_\_\_ gpm  
 Est. Yield \_\_\_\_\_ gpm: Well water was \_\_\_\_\_ ft. after \_\_\_\_\_ hours pumping \_\_\_\_\_ gpm  
 Bore Hole Diameter **14** in. to **44.0** ft., and **7 7/8** in. to **58.5** ft.  
 WELL WATER TO BE USED AS:  
 1 Domestic 3 Feedlot 6 Oil field water supply 9 Dewatering **12 Other (Specify below)**  
 2 Irrigation 4 Industrial 7 Lawn and garden only **10 Observation well** **Monitoring Well**  
 Was a chemical/bacteriological sample submitted to Department? Yes  No \_\_\_\_\_; If yes, mo/day/yr sample was submitted **08/31/83** Water Well Disinfected? Yes \_\_\_\_\_ No

5 TYPE OF BLANK CASING USED:  
 1 Steel 3 RMP (SR) 5 Wrought iron 8 Concrete tile CASING JOINTS: Glued \_\_\_\_\_ Clamped \_\_\_\_\_  
**2 PVC** 4 ABS 6 Asbestos-Cement 9 Other (specify below) Welded \_\_\_\_\_  
 7 Fiberglass Threaded

Blank casing diameter **10** in. to **44.0** ft., Dia **4** in. to **53.6** ft., Dia \_\_\_\_\_ in. to \_\_\_\_\_ ft.  
 Casing height above land surface **2.5 ft.**, weight **10 in. = 8; 4 in. = 2** lbs./ft. Wall thickness or gauge No. **Schedule 40**

TYPE OF SCREEN OR PERFORATION MATERIAL:  
 1 Steel 3 Stainless steel 5 Fiberglass **7 PVC** 10 Asbestos-cement  
 2 Brass 4 Galvanized steel 6 Concrete tile 8 RMP (SR) 11 Other (specify) \_\_\_\_\_  
 12 None used (open hole)

SCREEN OR PERFORATION OPENINGS ARE:  
 1 Continuous slot **3 Mill slot** 5 Gauzed wrapped 8 Saw cut 11 None (open hole)  
 2 Louvered shutter 4 Key punched 6 Wire wrapped 9 Drilled holes  
 7 Torch cut 10 Other (specify) \_\_\_\_\_

SCREEN-PERFORATED INTERVALS: From **53.6** ft. to **58.0** ft., From \_\_\_\_\_ ft. to \_\_\_\_\_ ft.  
 GRAVEL PACK INTERVALS: From **48.5** ft. to **58.5** ft., From \_\_\_\_\_ ft. to \_\_\_\_\_ ft.

6 GROUT MATERIAL: **1 Neat cement** 2 Cement grout **3 Bentonite** 4 Other \_\_\_\_\_  
 Grout Intervals: From **0.0** ft. to **48.5** ft., From \_\_\_\_\_ ft. to \_\_\_\_\_ ft.

What is the nearest source of possible contamination:  
 1 Septic tank 4 Lateral lines 7 Pit privy 10 Livestock pens 14 Abandoned water well  
 2 Sewer lines 5 Cess pool 8 Sewage lagoon 11 Fuel storage 15 Oil well/Gas well  
 3 Watertight sewer lines 6 Seepage pit 9 Feedyard 12 Fertilizer storage **16 Other (specify below)**  
 13 Insecticide storage **Hazardous Waste Facility**  
 Direction from well? **North** How many feet? **Approx. 360**

FROM	TO	LITHOLOGIC LOG	FROM	TO	LITHOLOGIC LOG
<b>0.0 feet</b>	<b>57 feet</b>	<b>Brown plastic to highly plastic CLAY to weathered CLAY-SHALE with trace to some calcium carbonate nodules</b>			
<b>57 feet</b>	<b>58.5 feet</b>	<b>BEDROCK - weathered gray SHALE</b>			

7 CONTRACTOR'S OR LANDOWNER'S CERTIFICATION: This water well was **(1) constructed**, (2) reconstructed, or (3) plugged under my jurisdiction and was completed on (mo/day/year) **07/26/83** and this record is true to the best of my knowledge and belief. Kansas Water Well Contractor's License No. **361** This Water Well Record was completed on (mo/day/yr) **9/7/83**

under the business name of **Cox-Beswick Irrigation Service Inc.** by (signature) **Francis Cox**  
 INSTRUCTIONS: Use typewriter or ball point pen, PLEASE PRESS FIRMLY and PRINT clearly. Please fill in blanks, underline or circle the correct answers. Send top three copies to Kansas Department of Health and Environment, Division of Environment, Environmental Geology Section, Topeka, KS 66620. Send one to WATER WELL OWNER and retain one for your records.