

LOCATION OF WATER WELL: Fraction SE 1/4 NE 1/4 SW 1/4 Section Number 26 Township Number T 25 S Range Number R 2 EW

Distance and direction from nearest town or city street address of well if located within city?


3 miles S.E. OF FURLEY, Ks.

WATER WELL OWNER: NIES RR#, St. Address, Box #: 8908 N. 107TH EAST City, State, ZIP Code: VALLEY CENTER, Ks. 67147

Board of Agriculture, Division of Water Resources Application Number:

LOCATE WELL'S LOCATION WITH AN "X" IN SECTION BOX:

DEPTH OF COMPLETED WELL: 28.0 ft. ELEVATION: 1373.8

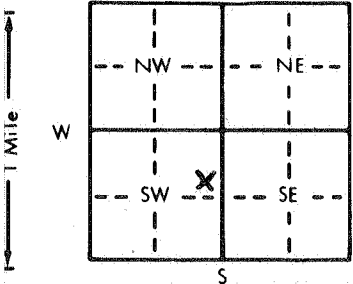

Depth(s) Groundwater Encountered 1. 15.5 ft. 2. ft. 3. ft. WELL'S STATIC WATER LEVEL 15.5 ft. below land surface measured on mo/day/yr 2/13/82

NA Pump test data: Well water was ft. after hours pumping gpm Est. Yield gpm: Well water was ft. after hours pumping gpm Bore Hole Diameter 6 in. to 26.5 ft., and 2 in. to 28.0 ft.

WELL WATER TO BE USED AS: 5 Public water supply 8 Air conditioning 11 Injection well 1 Domestic 3 Feedlot 6 Oil field water supply 9 Dewatering 12 Other (Specify below) 2 Irrigation 4 Industrial 7 Lawn and garden only 10 Observation well UNUSABLE FOR HOME

TYPE OF BLANK CASING USED: NA

5 Wrought iron 8 Concrete tile CASING JOINTS: Glued Clamped 1 Steel 3 RMP (SR) 6 Asbestos-Cement 9 Other (specify below) Welded 2 PVC 4 ABS 7 Fiberglass Threaded

Blank casing diameter in. to ft., Dia in. to ft., Dia in. to ft. Casing height above land surface in., weight lbs./ft. Wall thickness or gauge No.

TYPE OF SCREEN OR PERFORATION MATERIAL: NA

7 PVC 10 Asbestos-cement 1 Steel 3 Stainless steel 5 Fiberglass 8 RMP (SR) 11 Other (specify) 2 Brass 4 Galvanized steel 6 Concrete tile 9 ABS 12 None used (open hole)

SCREEN OR PERFORATION OPENINGS ARE: NA

5 Gauzed wrapped 8 Saw cut 11 None (open hole) 1 Continuous slot 3 Mill slot 6 Wire wrapped 9 Drilled holes 2 Louvered shutter 4 Key punched 7 Torch cut 10 Other (specify)

SCREEN-PERFORATED INTERVALS: From ft. to ft., From ft. to ft. GRAVEL PACK INTERVALS: From ft. to ft., From ft. to ft.

GROUT MATERIAL: 1 Neat cement 2 Cement grout 3 Bentonite 4 Other

Grout Intervals: From 0.0 ft. to 28.0 ft., From ft. to ft., From ft. to ft.

What is the nearest source of possible contamination: OLD TANKAGE FORMER PEB STORAGE AREA 10 Livestock pens 14 Abandoned water well 1 Septic tank 4 Lateral lines 7 Pit privy STORAGE AREA 11 Fuel storage 15 Oil well/Gas well 2 Sewer lines 5 Cess pool 8 Sewage lagoon 12 Fertilizer storage 16 Other (specify below) 3 Watertight sewer lines 6 Seepage pit 9 Feedyard 13 Insecticide storage HAZ WASTE FACILITY

Direction from well? WEST NORTHWEST

Table with columns: FROM, TO, LITHOLOGIC LOG. Entry: 0.0 (FT) to 28.0 (FT) BROWN, PLASTIC TO HEAVY PLASTIC CLAY TO WEATHERED CLAY-SHALES, WITH TRACE TO SOME CALCIUM CARBONATE NODULES

CONTRACTOR'S OR LANDOWNER'S CERTIFICATION: This water well was (1) constructed, (2) reconstructed, or (3) plugged under my jurisdiction and was completed on (mo/day/year) 2/19/82 and this record is true to the best of my knowledge and belief. Kansas Water Well Contractor's License No. 416 This Water Well Record was completed on (mo/day/yr) 5/30/82

under the business name of TERRACON CONSULTANTS INC. by signature [Signature] INSTRUCTIONS: Use typewriter or ball point pen, PLEASE PRESS FIRMLY and PRINT clearly. Please fill in blanks, underline or circle the correct answers. Send top three copies to Kansas Department of Health and Environment, Division of Environment, Environmental Geology Section, Topeka, KS 66620. Send one to WATER WELL OWNER and retain one for your records.