


LOCATION OF WATER WELL: Fraction SE 1/4 NW 1/4 SW 1/4 Section Number 26 Township Number T 25 S Range Number R 2

County: SEDGWICK Distance and direction from nearest town or city street address of well if located within city? 3 miles S.E. of FURLEY Ks.

WATER WELL OWNER: NIES Board of Agriculture, Division of Water Resources Application Number: RR#, St. Address, Box #: 8808 N. 127th East City, State, ZIP Code: VALLEY CENTER, Ks. 67147

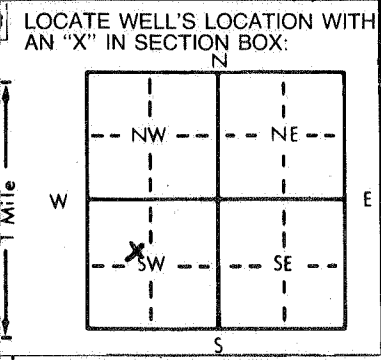

LOCATE WELL'S LOCATION WITH AN 'X' IN SECTION BOX: DEPTH OF COMPLETED WELL: 37.0 ft. ELEVATION: 1382.0 ft. WELL'S STATIC WATER LEVEL: 33.0 ft. below land surface measured on mo/day/yr 3/9/82

TYPE OF BLANK CASING USED: 1 Steel 2 PVC 3 RMP (SR) 4 ABS 5 Wrought iron 6 Asbestos-Cement 7 Fiberglass 8 Concrete tile 9 Other (specify below) 10 Observation well 11 Injection well 12 Other (Specify below) MONITORING WELL

TYPE OF SCREEN OR PERFORATION MATERIAL: 1 Steel 2 Brass 3 Stainless steel 4 Galvanized steel 5 Fiberglass 6 Concrete tile 7 PVC 8 RMP (SR) 9 ABS 10 Asbestos-cement 11 Other (specify) 12 None used (open hole)

SCREEN OR PERFORATION OPENINGS ARE: 1 Continuous slot 2 Louvered shutter 3 Mill slot 4 Key punched 5 Gauzed wrapped 6 Wire wrapped 7 Torch cut 8 Saw cut 9 Drilled holes 10 Other (specify) 11 None (open hole)

SCREEN-PERFORATED INTERVALS: From 26.0 ft. to 36.0 ft. GRAVEL PACK INTERVALS: From 12.0 ft. to 37.0 ft.

GROUT MATERIAL: 1 Neat cement 2 Cement grout 3 Bentonite 4 Other Grout Intervals: From 0.0 ft. to 12.0 ft. What is the nearest source of possible contamination: Drum Disposal Trench D-30

Table with columns: FROM, TO, LITHOLOGIC LOG. Entry: FROM 0.0 (ft) TO 37.0 (ft) LITHOLOGIC LOG: BROWN PLASTIC TO HIGHLY PLASTIC CLAY TO WEATHERED CLAY WITH TRACES TO SOME CALCIUM CARBONATE NODULES

CONTRACTOR'S OR LANDOWNER'S CERTIFICATION: This water well was (1) constructed (2) reconstructed, or (3) plugged under my jurisdiction and was completed on (mo/day/year) 2/22/82 and this record is true to the best of my knowledge and belief. Kansas Water Well Contractor's License No. 416 This Water Well Record was completed on (mo/day/yr) 5/19/82 under the business name of TERRACON CONSULTANTS INC. by (signature)