


LOCATION OF WATER WELL: County: STROGWIICK Fraction: NW 1/4 NW 1/4 SW 1/4 Section Number: 26 Township Number: T 25 S Range Number: R 2 W

Distance and direction from nearest town or city street address of well if located within city?

3 miles S.E. OF FURLEY Ks.

WATER WELL OWNER: NIES
RR#, St. Address, Box #: 8808 N. 127th EAST
City, State, ZIP Code: VALLEY CENTER, KS. 67147
Board of Agriculture, Division of Water Resources
Application Number:

LOCATE WELL'S LOCATION WITH AN "X" IN SECTION BOX: 4 DEPTH OF COMPLETED WELL: 62.7 ft. ELEVATION: 1389.5
Depth(s) Groundwater Encountered: 1 54.0 ft. 2 ft. 3 ft.

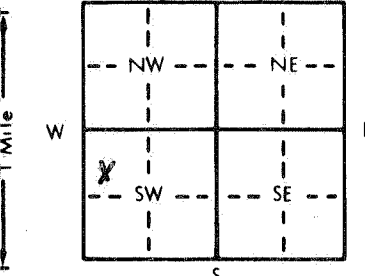

WELL'S STATIC WATER LEVEL: 54.0 ft. below land surface measured on mo/day/yr 4/1/82
Pump test data: Well water was NA ft. after 778 hours pumping 62.7 gpm
Est. Yield NA gpm: Well water was NA ft. after 778 hours pumping 62.7 gpm
Bore Hole Diameter: 14 in. to 49.6 ft., and 778 in. to 62.7 ft.
WELL WATER TO BE USED AS:
1 Domestic 3 Feedlot 6 Oil field water supply 9 Dewatering 12 Other (Specify below) MONITORING WELL
2 Irrigation 4 Industrial 7 Lawn and garden only 10 Observation well
Was a chemical/bacteriological sample submitted to Department? Yes No ; If yes, mo/day/yr sample was submitted 3/19+25/82 Water Well Disinfected? Yes No

TYPE OF BLANK CASING USED:
1 Steel 3 RMP (SR) 5 Wrought iron 8 Concrete tile CASING JOINTS: Glued Clamped
2 PVC 4 ABS 6 Asbestos-Cement 9 Other (specify below) Welded
7 Fiberglass Threaded

Blank casing diameter: 10 in. to 49.6 ft., Dia 4 in. to 57.3 ft., Dia 57.3 in. to 57.3 ft.
Casing height above land surface: 2.5 ft. in., weight 10in=8; 4in=2 lbs./ft. Wall thickness or gauge No. 59.40

TYPE OF SCREEN OR PERFORATION MATERIAL:
1 Steel 3 Stainless steel 5 Fiberglass 8 RMP (SR) 10 Asbestos-cement
2 Brass 4 Galvanized steel 6 Concrete tile 9 ABS 11 Other (specify)
12 None used (open hole)

SCREEN OR PERFORATION OPENINGS ARE:
1 Continuous slot 3 Mill slot 5 Gauzed wrapped 8 Saw cut 11 None (open hole)
2 Louvered shutter 4 Key punched 6 Wire wrapped 9 Drilled holes
7 Torch cut 10 Other (specify)

SCREEN-PERFORATED INTERVALS: From 57.3 ft. to 61.4 ft. From 61.4 ft. to 61.4 ft.

GRAVEL PACK INTERVALS: From 53.5 ft. to 62.7 ft. From 62.7 ft. to 62.7 ft.

GROUT MATERIAL: 1 Neat cement 2 Cement grout 3 Bentonite 4 Other
Grout intervals: From 0.0 ft. to 53.5 ft. From 53.5 ft. to 53.5 ft. From 53.5 ft. to 53.5 ft.

What is the nearest source of possible contamination: EVAPORATION POND E1
1 Septic tank 4 Lateral lines 7 Pit privy 10 Livestock pens 14 Abandoned water well
2 Sewer lines 5 Cess pool 8 Sewage lagoon 11 Fuel storage 15 Oil well/Gas well
3 Watertight sewer lines 6 Seepage pit 9 Feedyard 12 Fertilizer storage 16 Other (Specify below) HAZ. WASTE FACILITY
13 Insecticide storage
Direction from well? EAST How many feet? 10 APPROX.

FROM	TO	LITHOLOGIC LOG	FROM	TO	LITHOLOGIC LOG
<u>2.0</u> ft.	<u>~57</u> ft.	<u>BROWN PLASTIC TO HIGHLY PLASTIC CLAY TO WEATHERED CLAY SHALE WITH TRACE TO SOME CALCIUM CARBONATE NODULES</u>			
<u>~57</u> ft.	<u>62.7</u> ft.	<u>BEDROCK - INTERBEDDED Gypsum AND GRAY SHALE</u>			

CONTRACTOR'S OR LANDOWNER'S CERTIFICATION: This water well was (1) constructed (2) reconstructed, or (3) plugged under my jurisdiction and was completed on (mo/day/year) 3/19/82 and this record is true to the best of my knowledge and belief. Kansas Water Well Contractor's License No. 361 This Water Well Record was completed on (mo/day/year) 5/19/82 under the business name of Low-Bowick Irrigation Service Inc. by signature Frank Cox

INSTRUCTIONS: Use typewriter or ball point pen, PLEASE PRESS FIRMLY and PRINT clearly. Please fill in blanks, underline or circle the correct answers. Send top three copies to Kansas Department of Health and Environment, Division of Environment, Environmental Geology Section, Topeka, KS 66620. Send one to WATER WELL OWNER and retain one for your records.