

1 LOCATION OF WATER WELL: Fraction NE 1/4 NW 1/4 NW 1/4 Section Number 26 Township Number T 25 S Range Number R 2

Distance and direction from nearest town or city street address of well if located within city?

3 mi. S0E0 OF FURLEY, KS.


2 WATER WELL OWNER: NISS RR# 8808 N. 127th East City, State, ZIP Code VALLEY CENTER, KS. 67147

Board of Agriculture, Division of Water Resources

Application Number:

3 LOCATE WELL'S LOCATION WITH AN "X" IN SECTION BOX:

4 DEPTH OF COMPLETED WELL 13.5 ft. ELEVATION: 1338.3

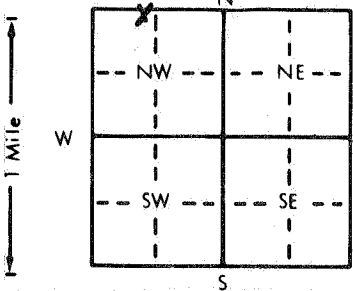

Depth(s) Groundwater Encountered 1. 7.9 ft. 2. ft. 3. ft.

WELL'S STATIC WATER LEVEL 7.9 ft. below land surface measured on mo/day/yr 4/1/82

NA Pump test data: Well water was ft. after hours pumping gpm

Est. Yield gpm: Well water was ft. after hours pumping gpm

Bore Hole Diameter 6 in. to 13.5 ft. and in to ft.

WELL WATER TO BE USED AS: 5 Public water supply 8 Air conditioning 11 Injection well

1 Domestic 3 Feedlot 6 Oil field water supply 9 Dewatering 12 Other (Specify below)

2 Irrigation 4 Industrial 7 Lawn and garden only 10 Observation well MONITORING WELL

Was a chemical/bacteriological sample submitted to Department? Yes No; If yes, mo/day/yr sample was submitted 3/30/82 4/1/82

Water Well Disinfected? Yes No

5 TYPE OF BLANK CASING USED:

- 1 Steel 3 RMP (SR) 5 Wrought iron 8 Concrete tile CASING JOINTS: Glued Clamped
2 PVC 4 ABS 6 Asbestos-Cement 9 Other (specify below) Welded
7 Fiberglass Threaded

Blank casing diameter 2 in. to 7.5 ft. Dia. Casing height above land surface 1.8 ft. weight 0.70 lbs./ft. Wall thickness or gauge No. SCH 40

TYPE OF SCREEN OR PERFORATION MATERIAL:

- 1 Steel 3 Stainless steel 5 Fiberglass 7 PVC 10 Asbestos-cement
2 Brass 4 Galvanized steel 6 Concrete tile 8 RMP (SR) 11 Other (specify)
12 None used (open hole)

SCREEN OR PERFORATION OPENINGS ARE:

- 1 Continuous slot 3 Mill slot 5 Gauzed wrapped 8 Saw cut 11 None (open hole)
2 Louvered shutter 4 Key punched 6 Wire wrapped 9 Drilled holes
7 Torch cut 10 Other (specify)

SCREEN-PERFORATED INTERVALS: From 7.5 ft. to 12.5 ft.

GRAVEL PACK INTERVALS: From 6.7 ft. to 13.5 ft.

6 GROUT MATERIAL: 1 Neat cement 2 Cement grout 3 Bentonite 4 Other

Grout intervals: From 0.0 ft. to 6.7 ft.

What is the nearest source of possible contamination:

- 1 Septic tank 4 Lateral lines 7 Pit privy 10 Livestock pens 14 Abandoned water well
2 Sewer lines 5 Cess pool 8 Sewage lagoon 11 Fuel storage 15 Oil well/Gas well
3 Watertight sewer lines 6 Seepage pit 9 Feedyard 12 Fertilizer storage 16 Other (specify below) Brine Disposal Well
13 Insecticide storage

Direction from well? SE

How many feet? approx. 440

Table with columns: FROM, TO, LITHOLOGIC LOG. Entry: 0.0 to 13.5 ft. BROWN MEDIUM-PLASTIC TO PLASTIC CLAY, CALCAREOUS IN PLACES

7 CONTRACTOR'S OR LANDOWNER'S CERTIFICATION: This water well was (1) constructed (2) reconstructed, or (3) plugged under my jurisdiction and was completed on (mo/day/year) 3/26/82

Water Well Contractor's License No. 416 This Water Well Record was completed on (mo/day/yr) 5/20/82

under the business name of TERRACON CONSULTANTS INC. by (signature)

INSTRUCTIONS: Use typewriter or ball point pen, PLEASE PRESS FIRMLY and PRINT clearly. Please fill in blanks, underline or circle the correct answers. Send top three copies to Kansas Department of Health and Environment, Division of Environment, Environmental Geology Section, Topeka, KS 66620. Send one to WATER WELL OWNER and retain one for your records.