


1 LOCATION OF WATER WELL: Fraction SE 1/4 NW 1/4 SW 1/4 Section Number 26 Township Number 25 S Range Number 2 E
 County: SEDGWICK
 Distance and direction from nearest town or city street address of well if located within city?

3 miles S.E. OF FURLEY, KS.

2 WATER WELL OWNER: NIES
 RR#, St. Address, Box #: 8808 N. 127th EAST
 City, State, ZIP Code: VALLEY CENTER, KS 67147
 Board of Agriculture, Division of Water Resources
 Application Number:

3 LOCATE WELL'S LOCATION WITH AN "X" IN SECTION BOX:

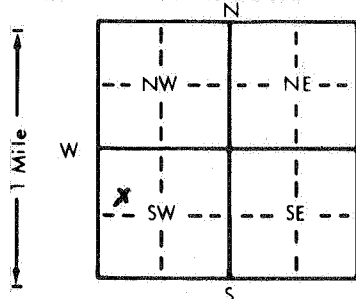

4 DEPTH OF COMPLETED WELL: 46.8 ft. ELEVATION: 1391.8

Depth(s) Groundwater Encountered 1. DRY ft. 2. _____ ft. 3. _____ ft.

WELL'S STATIC WATER LEVEL DRY ft. below land surface measured on mo/day/yr 3/9/82

NA Pump test data: Well water was _____ ft. after _____ hours pumping _____ gpm

Est. Yield _____ gpm: Well water was _____ ft. after _____ hours pumping _____ gpm

Bore Hole Diameter 6 in. to 46.8 ft. and _____ in. to _____ ft.

WELL WATER TO BE USED AS: 5 Public water supply 8 Air conditioning 11 Injection well

1 Domestic 3 Feedlot 6 Oil field water supply 9 Dewatering 12 Other (Specify below)

2 Irrigation 4 Industrial 7 Lawn and garden only 10 Observation well MONITORING WELL

Was a chemical/bacteriological sample submitted to Department? Yes _____ No ✓; If yes, mo/day/yr sample was submitted

Water Well Disinfected? Yes _____ No ✓

5 TYPE OF BLANK CASING USED: 5 Wrought iron 8 Concrete tile CASING JOINTS: Glued _____ Clamped _____

1 Steel 3 RMP (SR) 6 Asbestos-Cement 9 Other (specify below) Welded _____

2 PVC 4 ABS 7 Fiberglass _____ Threaded ✓

Blank casing diameter _____ in. to 35.8 ft. Dia. _____ in. to _____ ft. Dia. _____ in. to _____ ft.

Casing height above land surface 2.3 ft. weight 0.70 lbs./ft. Wall thickness or gauge No. SC40

TYPE OF SCREEN OR PERFORATION MATERIAL: 7 PVC 10 Asbestos-cement

1 Steel 3 Stainless steel 5 Fiberglass 8 RMP (SR) 11 Other (specify) _____

2 Brass 4 Galvanized steel 6 Concrete tile 9 ABS 12 None used (open hole)

SCREEN OR PERFORATION OPENINGS ARE: 5 Gauzed wrapped 8 Saw cut 11 None (open hole)

1 Continuous slot 3 Mill slot 6 Wire wrapped 9 Drilled holes

2 Louvered shutter 4 Key punched 7 Torch cut 10 Other (specify) _____

SCREEN-PERFORATED INTERVALS: From 35.8 ft. to 45.8 ft. From _____ ft. to _____ ft.

GRAVEL PACK INTERVALS: From 16.8 ft. to 46.8 ft. From _____ ft. to _____ ft.

From _____ ft. to _____ ft. From _____ ft. to _____ ft.

From _____ ft. to _____ ft. From _____ ft. to _____ ft.

6 GROUT MATERIAL: 1 Neat cement 2 Cement grout 3 Bentonite 4 Other _____

Grout Intervals: From 0.0 ft. to 16.8 ft. From _____ ft. to _____ ft. From _____ ft. to _____ ft.

What is the nearest source of possible contamination: DRUM DISPOSAL TRUCK 0-20 10 Livestock pens 14 Abandoned water well

1 Septic tank 4 Lateral lines 7 Pit privy 11 Fuel storage 15 Oil well/Gas well

2 Sewer lines 5 Cess pool 8 Sewage lagoon 12 Fertilizer storage 16 Other (specify below)

3 Watertight sewer lines 6 Seepage pit 9 Feedyard 13 Insecticide storage HAR WASTE FACILITY

Direction from well? EAST How many feet? 20 APPROX.

FROM TO LITHOLOGIC LOG FROM TO LITHOLOGIC LOG

0.0 46.8 Brown, plastic to highly plastic CLAY to weathered CLAY-SHALE with trace to some Calcium carbonate Modules

(feet) (feet)

7 CONTRACTOR'S OR LANDOWNER'S CERTIFICATION: This water well was (1) constructed, (2) reconstructed, or (3) plugged under my jurisdiction and was completed on (mo/day/year) 2/23/82 and this record is true to the best of my knowledge and belief. Kansas

Water Well Contractor's License No. 416 This Water Well Record was completed on (mo/day/yr) 5/19/82

under the business name of TERRACON CONSULTANTS INC by (signature) [Signature]

INSTRUCTIONS: Use typewriter or ball point pen, PLEASE PRESS FIRMLY and PRINT clearly. Please fill in blanks, underline or circle the correct answers. Send top three copies to Kansas Department of Health and Environment, Division of Environment, Environmental Geology Section, Topeka, KS 66620. Send one to WATER WELL OWNER and retain one for your records.