


1 LOCATION OF WATER WELL: Fraction NW 1/4 NW 1/4 SW 1/4 Section Number 26 Township Number T 25 S Range Number R 2 EW

Distance and direction from nearest town or city street address of well if located within city?

3 MILES S.E. OF FURLEY, KS.

2 WATER WELL OWNER: NIES RR#, St. Address, Box #: 8808 N. 127th East City, State, ZIP Code: VALLEY CENTER, KS 67147 Board of Agriculture, Division of Water Resources Application Number:

3 LOCATE WELL'S LOCATION WITH AN "X" IN SECTION BOX:

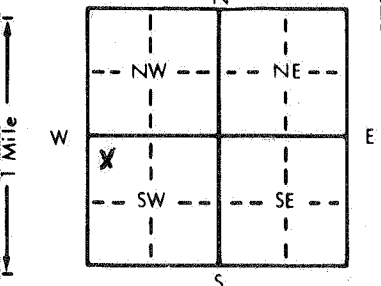

4 DEPTH OF COMPLETED WELL: 45.4 ft. ELEVATION: 1390.2

Depth(s) Groundwater Encountered: DRY ft. 2 ft. 3 ft. WELL'S STATIC WATER LEVEL: DRY ft. below land surface measured on mo/day/yr 3/9/82 Pump test data: Well water was NA ft. after hours pumping gpm Est. Yield gpm: Well water was NA ft. after hours pumping gpm Bore Hole Diameter: 6 in. to 45.4 ft. and in to ft. WELL WATER TO BE USED AS: 5 Public water supply 8 Air conditioning 11 Injection well 12 Other (Specify below) MONITORING WELL 1 Domestic 3 Feedlot 6 Oil field water supply 9 Dewatering 2 Irrigation 4 Industrial 7 Lawn and garden only 10 Observation well Was a chemical/bacteriological sample submitted to Department? Yes No; If yes, mo/day/yr sample was submitted Water Well Disinfected? Yes No

5 TYPE OF BLANK CASING USED: 1 Steel 3 RMP (SR) 5 Wrought iron 8 Concrete tile CASING JOINTS: Glued Clamped 2 Brass 4 Galvanized steel 6 Asbestos-Cement 9 Other (specify below) Welded 3 Mill slot 7 Fiberglass 10 Asbestos-cement Threaded

Blank casing diameter: 2 in. to 34.4 ft. Dia. in. to ft. Dia. in. to ft. Casing height above land surface: 2.7 ft. weight: 0.70 lbs./ft. Wall thickness or gauge No. SCH 40

TYPE OF SCREEN OR PERFORATION MATERIAL: 1 Steel 3 Stainless steel 5 Fiberglass 7 PVC 10 Asbestos-cement 2 Brass 4 Galvanized steel 6 Concrete tile 8 RMP (SR) 11 Other (specify) 9 ABS 12 None used (open hole)

SCREEN OR PERFORATION OPENINGS ARE: 1 Continuous slot 3 Mill slot 5 Gauzed wrapped 8 Saw cut 11 None (open hole) 2 Louvered shutter 4 Key punched 6 Wire wrapped 9 Drilled holes 7 Torch cut 10 Other (specify)

SCREEN-PERFORATED INTERVALS: From 34.4 ft. to 44.4 ft. From ft. to ft. From ft. to ft. From ft. to ft.

GRAVEL PACK INTERVALS: From 14.6 ft. to 45.4 ft. From ft. to ft. From ft. to ft. From ft. to ft.

6 GROUT MATERIAL: 1 Neat cement 2 Cement grout 3 Bentonite 4 Other Grout Intervals: From 0.0 ft. to 14.6 ft. From ft. to ft. From ft. to ft. From ft. to ft.

What is the nearest source of possible contamination: Evaporation Pond E-1 10 Livestock pens 14 Abandoned water well 1 Septic tank 4 Lateral lines 7 Pit privy 11 Fuel storage 15 Oil well/Gas well 2 Sewer lines 5 Cess pool 8 Sewage lagoon 12 Fertilizer storage 16 Other (specify below) 3 Watertight sewer lines 6 Seepage pit 9 Feedyard 13 Insecticide storage 17 HAZ WASTE FACILITY

Direction from well? EAST How many feet? 20 APPROX

Table with columns: FROM (FT), TO (FT), LITHOLOGIC LOG, FROM, TO, LITHOLOGIC LOG. Entry: 0.0 to 45.4 ft. BROWN PLASTIC TO HIGH KEY PLASTIC CLAY TO WEATHERED CLAY SHALE WITH TRACE TO SOME CALCIUM CARBONATE NODULES.

7 CONTRACTOR'S OR LANDOWNER'S CERTIFICATION: This water well was (1) constructed (2) reconstructed, or (3) plugged under my jurisdiction and was completed on (mo/day/year) 2/22/82 and this record is true to the best of my knowledge and belief. Kansas Water Well Contractor's License No. 416 This Water Well Record was completed on (mo/day/year) 5/12/82 under the business name of TERRACON CONSULTANTS INC. by signature [Signature]

INSTRUCTIONS: Use typewriter or ball point pen, PLEASE PRESS FIRMLY and PRINT clearly. Please fill in blanks, underline or circle the correct answers. Send top three copies to Kansas Department of Health and Environment, Division of Environment, Environmental Geology Section, Topeka, KS 66620. Send one to WATER WELL OWNER and retain one for your records.