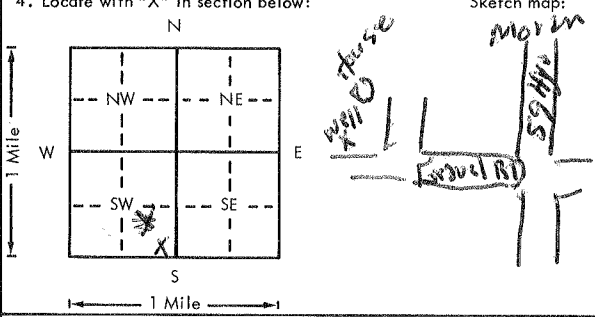


USE TYPEWRITER OR BALL  
POINT PEN-PRESS FIRMLY,  
PRINT CLEARLY.

WATER WELL RECORD  
KSA 82a-1201-1215

Kansas Department of Health and  
Environment-Division of Environment  
(Water well Contractors)  
Topeka, Kansas 66620

1. Location of well:	County <u>Allen</u>	Fraction <u>SE 1/4 SW 1/4</u>	Section number <u>23</u>	Township number <u>T 25</u>	Range number <u>S R 20</u>	<u>X</u> EW
2. Distance and direction from nearest town or city: <u>4 miles south - 1 mile west - 3/4 south of Moran</u> Street address of well location if in city: <u>Kansas</u>			3. Owner of well: <u>Dale LaRue - SR.</u> R.R. or street: <u>Moran, Kansas</u> City, state, zip code: <u>Moran, Kansas</u>			
4. Locate with "X" in section below: 			6. Bore hole dia. <u>8 3/4</u> in. Completion date <u>11/19/77</u> Well depth <u>150</u> ft.			
5. Type and color of material			7. <input checked="" type="checkbox"/> Cable tool <input type="checkbox"/> Rotary <input type="checkbox"/> Driven <input type="checkbox"/> Dug <input type="checkbox"/> Hollow rod <input type="checkbox"/> Jetted <input type="checkbox"/> Bored <input type="checkbox"/> Reverse rotary			
			8. Use: <input checked="" type="checkbox"/> Domestic <input type="checkbox"/> Public supply <input type="checkbox"/> Industry <input type="checkbox"/> Irrigation <input type="checkbox"/> Air conditioning <input type="checkbox"/> Stock <input type="checkbox"/> Lawn <input type="checkbox"/> Oil field water <input type="checkbox"/> Other			
			9. Casing: Material <u>Styrene</u> Height: Above or below Threaded <input type="checkbox"/> Welded <input type="checkbox"/> Surface <u>12</u> in. RMP <input type="checkbox"/> PVC <input checked="" type="checkbox"/> Weight <u>136</u> lbs./ft. Dia. <u>6</u> in. to <u>150</u> ft. depth <u>150</u> ft. Wall Thickness: inches or Dia. <u>6</u> in. to <u>150</u> ft. depth gage No. <u>255</u>			
			10. Screen: Manufacturer's name <u>Jet Set</u> Type <u>100</u> Dia. <u>6"</u> Slot/gauze <u>X</u> Length <u>136</u> Set between <u>14</u> ft. and <u>130</u> ft. ft. and <u>14</u> ft. Gravel pack? <input checked="" type="checkbox"/> Size range of material <u>3/4</u>			
			14. Well grouted? <input checked="" type="checkbox"/> With: <u>Neat cement</u> <input type="checkbox"/> Bentonite <input checked="" type="checkbox"/> Concrete Depth: From <u>0</u> ft. to <u>10</u> ft.			
			15. Nearest source of possible contamination: ft. <u>100</u> Direction <u>N</u> Type <u>Septic</u> Well disinfected upon completion? <input checked="" type="checkbox"/> Yes <input type="checkbox"/> No			
			16. Pump: <input checked="" type="checkbox"/> Not installed Manufacturer's name <u>Eureka</u> Model number <u>296</u> HP <u>1/4</u> Volts <u>115</u> Length of drop pipe <u>148</u> ft. capacity <u>1/4</u> g.p.m. Type: <input type="checkbox"/> Submersible <input type="checkbox"/> Turbine <input type="checkbox"/> Jet <input type="checkbox"/> Reciprocating <input type="checkbox"/> Centrifugal <input type="checkbox"/> Other			
18. Elevation:			20. Water well contractor's certification: This well was drilled under my jurisdiction and this report is true to the best of my knowledge and belief. <u>Eureka Well Service</u> <u>296</u> Business name License No. Address <u>Eureka, Kansas</u> Signed <u>James C. Cihlar</u> Date <u>1-9-78</u> Authorized representative			
19. Remarks:  Topography: <input type="checkbox"/> Hill <input type="checkbox"/> Slope <input checked="" type="checkbox"/> Upland <input type="checkbox"/> Valley						

Forward the white, blue and pink copies to the Department of Health and Environment

Form WWC-5