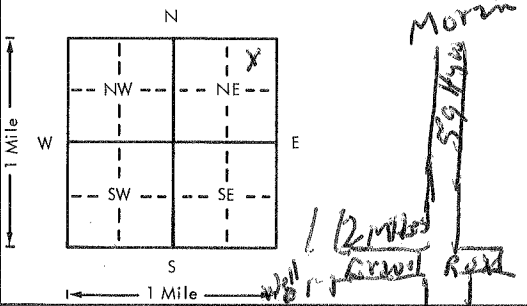


USE TYPEWRITER OR BALL
POINT PEN-PRESS FIRMLY,
PRINT CLEARLY.

WATER WELL RECORD
KSA 82a-1201-1215

Kansas Department of Health and
Environment-Division of Environment
(Water well Contractors)
Topeka, Kansas 66620

1. Location of well:		County <u>Allen</u>	Fraction <u>NE 1/4 NE 1/4 NE 1/4</u>	Section number <u>34</u>	Township number <u>T 25</u>	Range number <u>S R 20</u>
2. Distance and direction from nearest town or city: <u>5 miles south west Moran, Kans</u> Street address of well location if in city:				3. Owner of well: <u>Gary Covey</u> R.R. or street: City, state, zip code: <u>Moran, Kans</u>		
4. Locate with "X" in section below:		Sketch map:		6. Bore hole dia. <u>8 3/4</u> in. Completion date <u>11/5/77</u> Well depth <u>129</u> ft.		
				7. <input checked="" type="checkbox"/> Cable tool <input type="checkbox"/> Rotary <input type="checkbox"/> Driven <input type="checkbox"/> Dug <input type="checkbox"/> Hollow rod <input type="checkbox"/> Jetted <input type="checkbox"/> Bored <input type="checkbox"/> Reverse rotary		
5. Type and color of material		From	To	8. Use: <input type="checkbox"/> Domestic <input type="checkbox"/> Public supply <input type="checkbox"/> Industry <input type="checkbox"/> Irrigation <input type="checkbox"/> Air conditioning <input checked="" type="checkbox"/> Stock <input type="checkbox"/> Lawn <input type="checkbox"/> Oil field water <input type="checkbox"/> Other		
Soil		0	3	9. Casing: Material <u>Styrene</u> Height: Above or below Threaded <input type="checkbox"/> Welded <input type="checkbox"/> Surface <u>12</u> in. RMP <input type="checkbox"/> PVC <input checked="" type="checkbox"/> Weight <input type="checkbox"/> lbs./ft. Dia. <u>6</u> in. to <u>129</u> ft. depth Wall Thickness: inches or Dia. <input type="checkbox"/> in. to <input type="checkbox"/> ft. depth gage No. <u>255</u>		
Sand		3	10	10. Screen: Manufacturer's name <u>Flowmeter</u> <u>Jet-set</u> Type <u>100</u> Dia. <u>6</u> in. Slot/gauze <u>X</u> Length <u>109</u> Set between <u>2.0</u> ft. and <u>129</u> ft. ft. and <input type="checkbox"/> ft.		
Shale		10	20	Gravel pack? <input checked="" type="checkbox"/> Size range of material <u>3/4</u>		
Sand		20	30	11. Static water level: <input type="checkbox"/> mo./day/yr. <u>30</u> ft. below land surface Date <u>11/5/77</u>		
Shale		30	40	12. Pumping level below land surfaces: ft. after <input type="checkbox"/> hrs. pumping <input type="checkbox"/> g.p.m. ft. after <input type="checkbox"/> hrs. pumping <input type="checkbox"/> g.p.m. Estimated maximum yield <input type="checkbox"/> g.p.m.		
Lime Water		40	42	13. Water sample submitted: <input type="checkbox"/> mo./day/yr. <input type="checkbox"/> Yes <input type="checkbox"/> No Date <input type="checkbox"/>		
Lime		42	102	14. Well head completion: <input type="checkbox"/> Pitless adapter <input type="checkbox"/> Inches above grade		
Shale		102	104	15. Well grouted? <input checked="" type="checkbox"/> With: <input type="checkbox"/> Neat cement <input type="checkbox"/> Bentonite <input checked="" type="checkbox"/> Concrete Depth: From <u>0</u> ft. to <u>10</u> ft.		
Lime		105	108	16. Nearest source of possible contamination: ft. <u>200</u> Direction <u>South</u> Type <u>Septic</u> Well disinfected upon completion? <input type="checkbox"/> Yes <input type="checkbox"/> No		
Shale Sandy water		108	118	17. Pump: <input checked="" type="checkbox"/> Not installed Manufacturer's name <input type="checkbox"/> Model number <input type="checkbox"/> HP <input type="checkbox"/> Volts <input type="checkbox"/> Length of drop pipe <input type="checkbox"/> ft. capacity <input type="checkbox"/> g.p.m. Type: <input type="checkbox"/> Submersible <input type="checkbox"/> Turbine <input type="checkbox"/> Jet <input type="checkbox"/> Reciprocating <input type="checkbox"/> Centrifugal <input type="checkbox"/> Other		
Sandy Lime		118	129			
(Use a second sheet if needed)						
18. Elevation:		19. Remarks:		20. Water well contractor's certification: This well was drilled under my jurisdiction and this report is true to the best of my knowledge and belief. <u>Eureka Well Service 296</u> Business name License No. Address <u>Eureka, Kansas</u> Signed <u>Tom Gaskler</u> Date <u>1-9-78</u> Authorized representative		
Topography: <input type="checkbox"/> Hill <input checked="" type="checkbox"/> Slope <input type="checkbox"/> Upland <input type="checkbox"/> Valley						