


MW-14

Send one white copy to Kansas Department of Health & Environment, Geology Section, 1000 SW Jackson Street, Ste. 420, Topeka, KS 66612-1367. Send one copy to WATER WELL OWNER and retain one for your records.
Visit us at <http://www.kdheks.gov/waterwell/index.html> Telephone 785-296-5524.

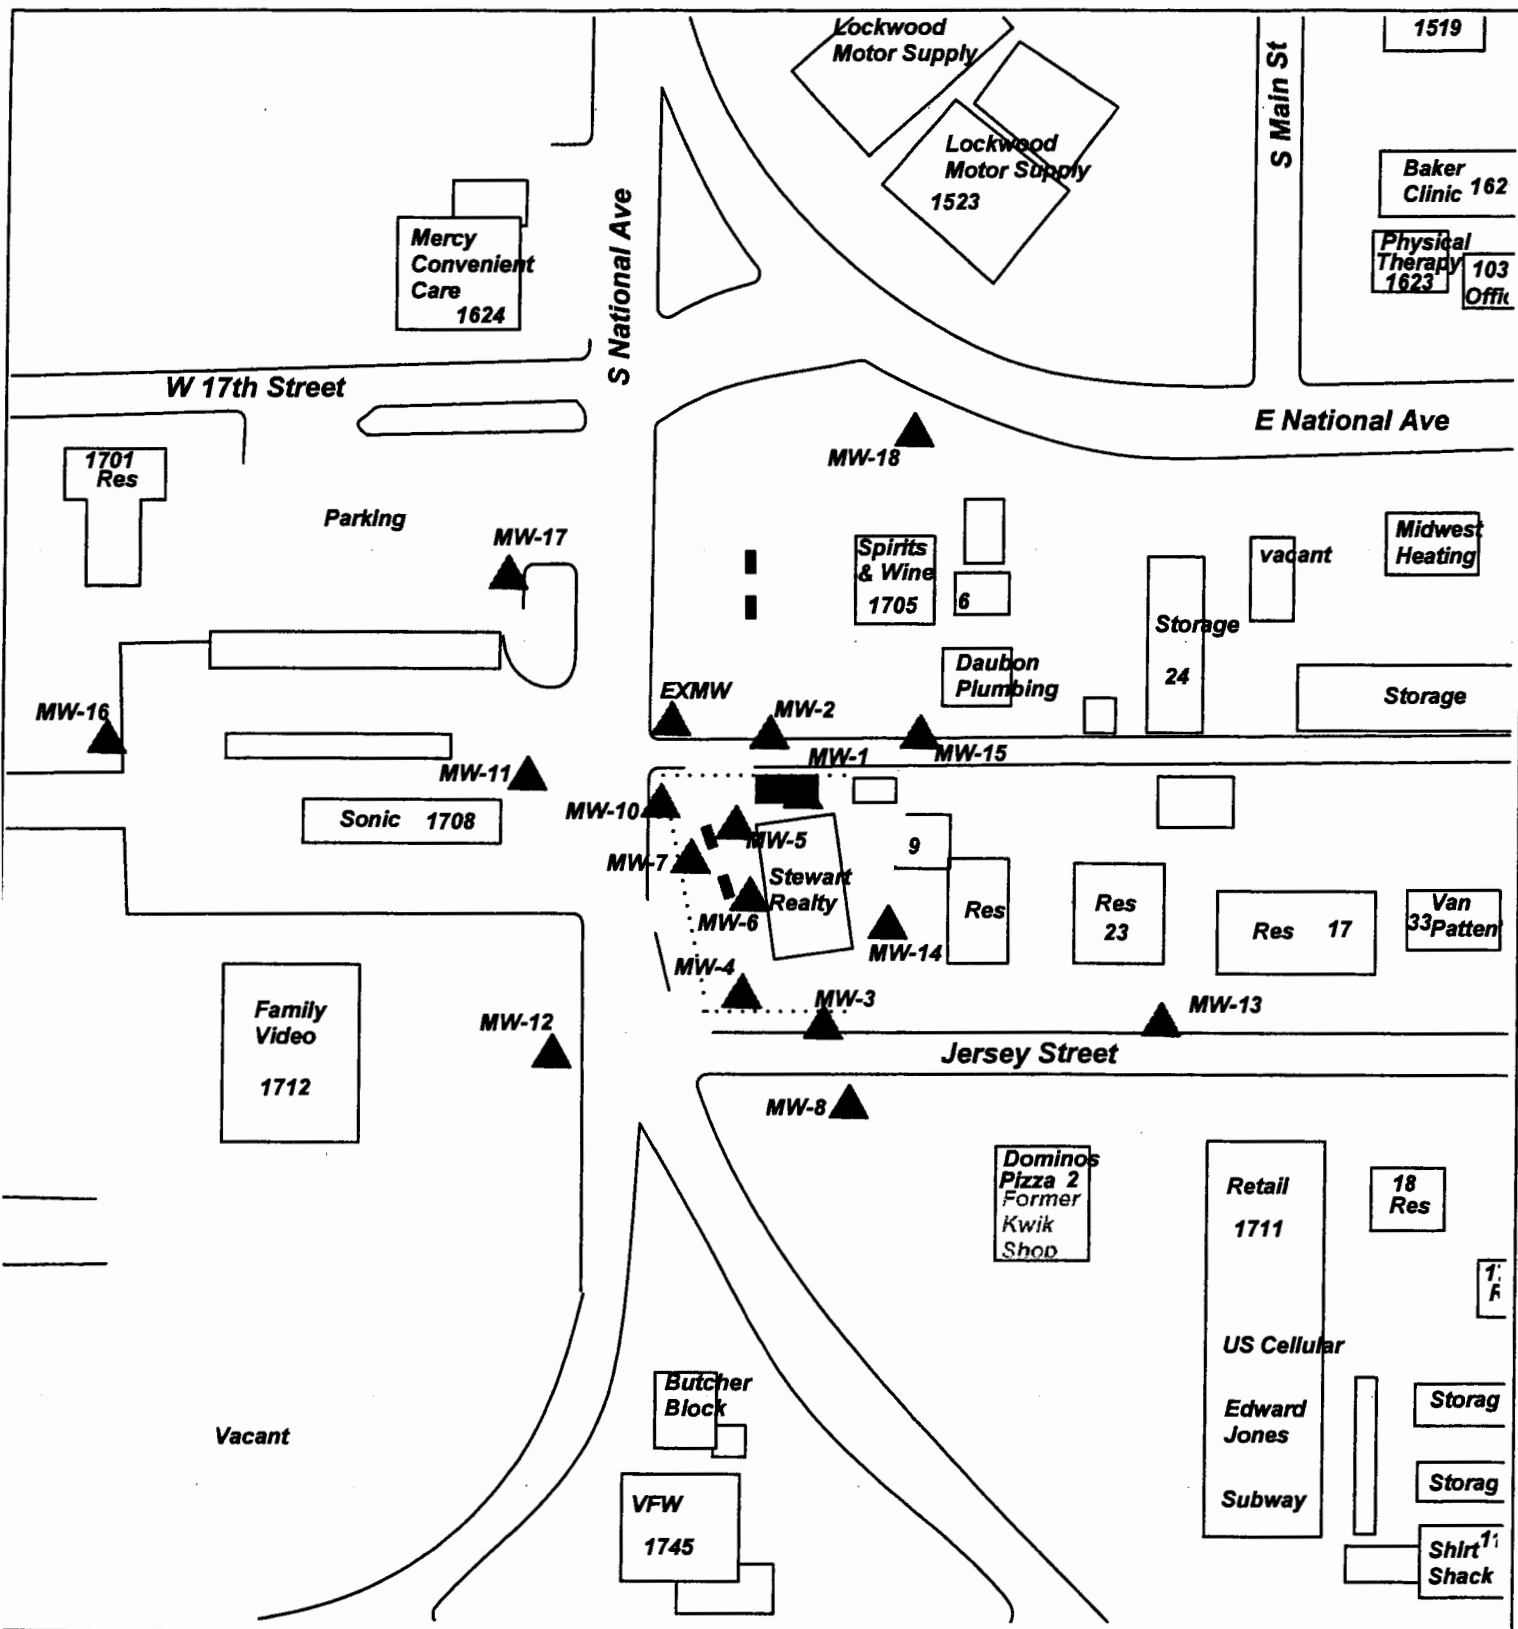

PROJECT: **STEWART REALTY**

ADDRESS: **1701 S. NATIONAL**

LOCATION: **FORT SCOTT, KS**

DRAWN BY: **B. JOHNSON** DATE: **2/22/18**

REVISED BY: **C. ROE** DATE: **10/25/18**

LET JOB #: **TM232** KONE JOB #: **U3-006-11963**

TITLE: **FIGURE 2.1
AREA BASE MAP
350' RADIUS**

AE **ASSOCIATED
ENVIRONMENTAL
INC.**

LEGEND:

- = FORMER UST BASIN/EXCAVATION
- = FORMER PUMP ISLAND
- = ABANDONED MONITOR WELL
- = MONITORING WELL
- = SUBJECT PROPERTY

SCALE: **1" = 100'**

0 50 100

NOTES: