


1	LOCATION OF WATER WELL:	Fraction	Section Number	Township Number	Range Number
	County: <i>Butler</i>	<i>SE 1/4 SW 1/4 NW 1/4</i>	<i>18</i>	<i>25-S</i>	<i>3-E</i>

Distance and direction from nearest town or city street address of well if located within city?
102 N Main Whitewater, KS *Mw #10*

2	WATER WELL OWNER: <i>Morton Weiss</i>	Board of Agriculture, Division of Water Resources
	RR #, St. Address, Box #: <i>RR #2 Box 5</i>	Application Number:
	City, State, ZIP Code: <i>Whitewater, KS 67154</i>	

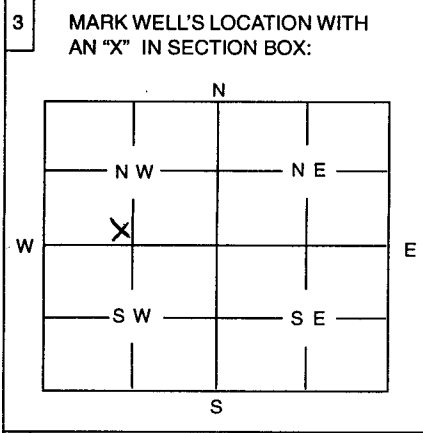

4	DEPTH OF WELL <i>24</i> ft												
	WELL'S STATIC WATER LEVEL ft.												
	WELL WAS USED AS:												
	<table border="0"> <tr> <td>1 Domestic</td> <td>5 Public Water Supply</td> <td>9 Dewatering</td> </tr> <tr> <td>2 Irrigation</td> <td>6 Oil Field Water Supply</td> <td><input checked="" type="checkbox"/> 10 Monitoring Well</td> </tr> <tr> <td>3 Feedlot</td> <td>7 Domestic (Lawn & Garden)</td> <td>11 Injection Well</td> </tr> <tr> <td>4 Industrial</td> <td>8 Air Conditioning</td> <td>12 Other</td> </tr> </table>	1 Domestic	5 Public Water Supply	9 Dewatering	2 Irrigation	6 Oil Field Water Supply	<input checked="" type="checkbox"/> 10 Monitoring Well	3 Feedlot	7 Domestic (Lawn & Garden)	11 Injection Well	4 Industrial	8 Air Conditioning	12 Other
1 Domestic	5 Public Water Supply	9 Dewatering											
2 Irrigation	6 Oil Field Water Supply	<input checked="" type="checkbox"/> 10 Monitoring Well											
3 Feedlot	7 Domestic (Lawn & Garden)	11 Injection Well											
4 Industrial	8 Air Conditioning	12 Other											
	Was a chemical / bacteriological sample submitted to Department? Yes No If yes, mo/day/yr sample was submitted												
	Water Well Disinfected: Yes No												

5	TYPE OF BLANK CASING USED:										
	<table border="0"> <tr> <td>1 Steel</td> <td>3 RMP (SR)</td> <td>5 Wrought</td> <td>7 Fiberglass</td> <td>9 Other (Specify below)</td> </tr> <tr> <td><input checked="" type="checkbox"/> 2 PVC</td> <td>4 ABS</td> <td>6 Asbestos-Cement</td> <td>8 Concrete Tile</td> <td></td> </tr> </table>	1 Steel	3 RMP (SR)	5 Wrought	7 Fiberglass	9 Other (Specify below)	<input checked="" type="checkbox"/> 2 PVC	4 ABS	6 Asbestos-Cement	8 Concrete Tile	
1 Steel	3 RMP (SR)	5 Wrought	7 Fiberglass	9 Other (Specify below)							
<input checked="" type="checkbox"/> 2 PVC	4 ABS	6 Asbestos-Cement	8 Concrete Tile								
	Blank casing diameter <i>2</i> in. Was casing pulled? Yes <input checked="" type="checkbox"/> No If yes, how much <i>14</i>										
	Casing height above or below land surface <i>0</i> in.										

6	GROUT PLUG MATERIAL:	1 Neat cement	2 Cement grout	<input checked="" type="checkbox"/> 3 Bentonite	4 Other <i>Top soil</i>																
	Grout Plug Intervals: From ft. to ft., From <i>24</i> ft. to <i>1</i> ft., From <i>1</i> to <i>0</i> ft.																				
	What is the nearest source of possible contamination:																				
	<table border="0"> <tr> <td>1 Septic tank</td> <td>6 Seepage pit</td> <td>11 Fuel storage</td> <td>16 Other (specify below)</td> </tr> <tr> <td>2 Sewer lines</td> <td>7 Pit privy</td> <td>12 Fertilizer storage</td> <td></td> </tr> <tr> <td>3 Watertight sewer lines</td> <td>8 Sewage lagoon</td> <td>13 Insecticide storage</td> <td></td> </tr> <tr> <td>4 Lateral lines</td> <td>9 Feedyard</td> <td>14 Abandoned water well</td> <td></td> </tr> <tr> <td>5 Cess Pool</td> <td>10 Livestock pens</td> <td>15 Oil well/Gas well</td> <td></td> </tr> </table>	1 Septic tank	6 Seepage pit	11 Fuel storage	16 Other (specify below)	2 Sewer lines	7 Pit privy	12 Fertilizer storage		3 Watertight sewer lines	8 Sewage lagoon	13 Insecticide storage		4 Lateral lines	9 Feedyard	14 Abandoned water well		5 Cess Pool	10 Livestock pens	15 Oil well/Gas well	
1 Septic tank	6 Seepage pit	11 Fuel storage	16 Other (specify below)																		
2 Sewer lines	7 Pit privy	12 Fertilizer storage																			
3 Watertight sewer lines	8 Sewage lagoon	13 Insecticide storage																			
4 Lateral lines	9 Feedyard	14 Abandoned water well																			
5 Cess Pool	10 Livestock pens	15 Oil well/Gas well																			
	Direction from well? <i>North East</i> How many feet? <i>80'</i>																				

FROM	TO	PLUGGING MATERIALS
<i>24</i>	<i>1</i>	<i>Bentonite</i>
<i>1</i>	<i>0</i>	<i>Top soil</i>

7	CONTRACTOR'S OR LANDOWNER'S CERTIFICATION: This water well was plugged under my jurisdiction and was completed on (mo/day/year) <i>8-7-01</i> and this record is true to the best of my knowledge and belief. Kansas Water Well Contractor's License No. <i>575</i> This Water Well Record was completed on (mo/day/year) <i>8-31-01</i> under the business name of <i>FUNKER DRILLING SERVICE</i>
	by (signature) <i>[Signature]</i>

INSTRUCTIONS: Use typewriter or ball point pen. Please press firmly and print clearly. Please fill in blanks, underline or circle the correct answers. Send top three copies to Kansas Department of Health and Environment, Bureau of Water, Topeka, Kansas 66620-0001. Telephone: 785/296-3565. Send one to Water Well Owner and retain one for your records.