


MW# 6

---	--	---	-----------------------------	--------------------------------	----------------------------

Distance and direction from nearest town or city street address of well if located within city?
102 N Main White Water Ks MW# 6

2 WATER WELL OWNER: Morton Weins
RR #, St. Address, Box #: RR2 Box 5
City, State, ZIP Code : White Water Ks 67154
Board of Agriculture, Division of Water Resources
Application Number: _____

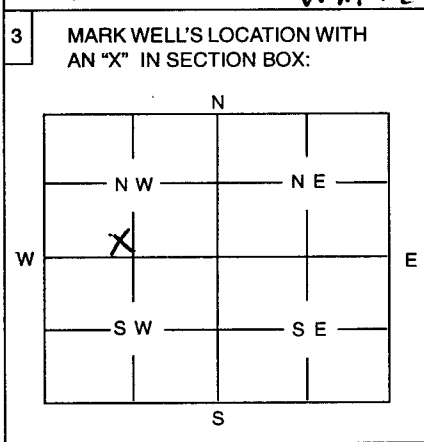

4 DEPTH OF WELL 24 ft
WELL'S STATIC WATER LEVEL ft.
WELL WAS USED AS:
1 Domestic 5 Public Water Supply 9 Dewatering
2 Irrigation 6 Oil Field Water Supply 10 Monitoring Well
3 Feedlot 7 Domestic (Lawn & Garden) 11 Injection Well
4 Industrial 8 Air Conditioning 12 Other

Was a chemical / bacteriological sample submitted to Department? Yes No
If yes, mo/day/yr sample was submitted

Water Well Disinfected: Yes No

5 TYPE OF BLANK CASING USED:
1 Steel 3 RMP (SR) 5 Wrought 7 Fiberglass 9 Other (Specify below)
2 PVC 4 ABS 6 Asbestos-Cement 8 Concrete Tile

Blank casing diameter 2 in. Was casing pulled? Yes No If yes, how much 14

Casing height above or below land surface 0 in.

6 GROUT PLUG MATERIAL: 1 Neat cement 2 Cement grout 3 Bentonite 4 Other TOPSOIL

Grout Plug Intervals: From ft. to ft., From 24 ft. to 1 ft., From 1 to 0 ft.

What is the nearest source of possible contamination:
1 Septic tank 6 Seepage pit 11 Fuel storage 16 Other (specify below)
2 Sewer lines 7 Pit privy 12 Fertilizer storage

3 Watertight sewer lines 8 Sewage lagoon 13 Insecticide storage

4 Lateral lines 9 Feedyard 14 Abandoned water well

5 Cess Pool 10 Livestock pens 15 Oil well/Gas well

Direction from well? North How many feet? 601

FROM	TO	PLUGGING MATERIALS
<u>24</u>	<u>1</u>	<u>Bentonite</u>
<u>1</u>	<u>0</u>	<u>Topsoil</u>

7 CONTRACTOR'S OR LANDOWNER'S CERTIFICATION: This water well was plugged under my jurisdiction and was completed on (mo/day/year) 8-7-01 and this record is true to the best of my knowledge and belief. Kansas Water Well Contractor's License No. 575 This Water Well Record was completed on (mo/day/year) 8-31-01 under the business name of FLORES DRILLING SERVICE, L.L.C. by (signature) [Signature]

INSTRUCTIONS: Use typewriter or ball point pen. Please press firmly and print clearly. Please fill in blanks, underline or circle the correct answers. Send top three copies to Kansas Department of Health and Environment, Bureau of Water, Topeka, Kansas 66620-0001. Telephone: 785/296-3565. Send one to Water Well Owner and retain one for your records.