


1 LOCATION OF WATER WELL: County: Butler Fraction: NW 1/4 NW 1/4 SE 1/4 Section Number: 18 Township Number: T 25 S Range Number: R 3E EW

Distance and direction from nearest town or city street address of well if located within city? 16320 NW 30th Benton

2 WATER WELL OWNER: Doug Hague RR#, St. Address, Box #: 16320 N.W. 30th, Benton, KS 67017 City, State, ZIP Code

Board of Agriculture, Division of Water Resources Application Number:

3 LOCATE WELL'S LOCATION WITH AN "X" IN SECTION BOX:

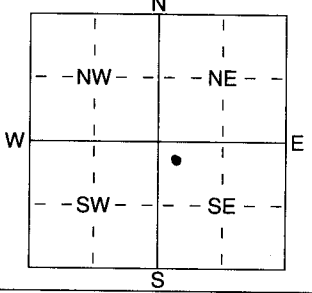

4 DEPTH OF COMPLETED WELL: 120 ft. ELEVATION: 7-14-03 ft.

Depth(s) Groundwater Encountered: 1 ft. 2 ft. 3 ft. WELL'S STATIC WATER LEVEL: 36 ft. below land surface measured on mo/day/yr. Pump test data: Well water was ... ft. after ... hours pumping ... gpm. Est. Yield ... gpm: Well water was ... ft. after ... hours pumping ... gpm. WELL WATER TO BE USED AS: 1 Domestic, 2 Irrigation, 3 Feedlot, 4 Industrial, 5 Public water supply, 6 Oil field water supply, 7 Domestic (lawn & garden), 8 Air conditioning, 9 Dewatering, 10 Monitoring well, 11 Injection well, 12 Other (Specify below)

Was a chemical/bacteriological sample submitted to Department? Yes No X; If yes, mo/day/yrs sample was submitted Water Well Disinfected? Yes X No

5 TYPE OF BLANK CASING USED: 1 Steel, 2 PVC, 3 RMP (SR), 4 ABS, 5 Wrought iron, 6 Asbestos-Cement, 7 Fiberglass, 8 Concrete tile, 9 Other (specify below). CASING JOINTS: Glued X, Clamped, Welded, Threaded

Blank casing diameter: 5 in. to 6.0 ft., Dia. Casing height above land surface: 12 in., weight lbs./ft. Wall thickness or gauge No. 5DR26

TYPE OF SCREEN OR PERFORATION MATERIAL: 1 Steel, 2 Brass, 3 Stainless Steel, 4 Galvanized Steel, 5 Fiberglass, 6 Concrete tile, 7 PVC, 8 RMP (SR), 9 ABS, 10 Asbestos-Cement, 11 Other (Specify), 12 None used (open hole)

SCREEN OR PERFORATION OPENINGS ARE: 1 Continuous slot, 2 Louvered shutter, 3 Mill slot, 4 Key punched, 5 Gauzed wrapped, 6 Wire wrapped, 7 Torch cut, 8 Saw cut, 9 Drilled holes, 11 None (open hole), 10 Other (specify)

SCREEN-PERFORATED INTERVALS: From 6.0 ft. to 10.0 ft. GRAVEL PACK INTERVALS: From 2.0 ft. to 10.0 ft.

6 GROUT MATERIAL: 1 Neat cement, 2 Cement grout, 3 Bentonite, 4 Other. Grout Intervals: From 4 ft. to 20 ft.

What is the nearest source of possible contamination: 1 Septic tank, 2 Sewer lines, 3 Watertight sewer lines, 4 Lateral lines, 5 Cess pool, 6 Seepage pit, 7 Pit privy, 8 Sewage lagoon, 9 Feedyard, 10 Livestock pens, 11 Fuel storage, 12 Fertilizer storage, 13 Insecticide storage, 14 Abandoned water well, 15 Oil well/Gas well, 16 Other (specify below)

Direction from well? How many feet?

Table with columns: FROM, TO, LITHOLOGIC LOG, FROM, TO, PLUGGING INTERVALS. Rows show depth intervals from 0 to 100 feet with lithology descriptions like 'clay', 'sand', 'shale', 'shale w/ lim shls'.

7 CONTRACTOR'S OR LANDOWNER'S CERTIFICATION: This water well was constructed, (2) reconstructed, or (3) plugged under my jurisdiction and was completed on (mo/day/year) 7-14-03 and this record is true to the best of my knowledge and belief. Kansas Water Well Contractor's Licence No 171. This Water Well Record was completed on (mo/day/yr) 8-8-03 under the business name of G+S Drilling Inc. by (signature)