


1 LOCATION OF WATER WELL: <b>Butler</b>	FRACTION <b>NE 1/4 NE 1/4 NW 1/4</b>	Section Number <b>23</b>	Township Number <b>T 25 S</b>	Range Number <b>R 3E E/W</b>
--	---	-----------------------------	----------------------------------	---------------------------------

Distance and direction from nearest town or city street address of well if located within city?  
**5 m. N. of Hwy. 254 to 101st N., 4 1/2 m. E. of Whitewater Road, S. side**

2 WATER WELL OWNER: <b>WATSON, Bill</b> RR#, ST. ADDRESS, BOX #: <b>P.O. Box 637</b> CITY, STATE, ZIP CODE: <b>Towanda, Kansas</b>	Board of Agriculture, Division of Water Resource Application Number:
--	---

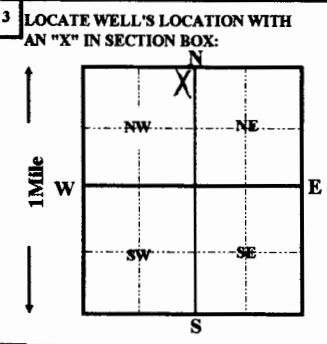

4 DEPTH OF COMPLETED WELL <b>80</b> ft. ELEVATION:	1 ft. 2 ft. 3 ft.
Depth(s) groundwater Encountered	1 ft. 2 ft. 3 ft.
WELL'S STATIC WATER LEVEL <b>15</b> FT. BELOW LAND SURFACE MEASURED ON <b>08/10/1995</b>	mo/day/yr
Pump test data:	Well water was ft. after hours pumping gpm
Est. Yield gpm:	Well water was ft. after hours pumping gpm
Bore Hole Diameter <b>12</b> in. to <b>80</b> ft. and in. to ft.	
WELL WATER TO BE USED AS:	5 Public water supply 8 Air conditioning 11 Injection well
1 Domestic 3 Feedlot 6 Oil field water supply 9 Dewatering 12 Other (Specify below)	
2 Irrigation 4 Industrial 7 Lawn and garden only 10 Monitoring well	
Was a chemical/bacteriological sample submitted to Department? Yes	No <input checked="" type="checkbox"/> ; If yes, mo/day/yr sample was submitted
Water Well Disinfected?	Yes <input checked="" type="checkbox"/> No

5 TYPE OF CASING USED:	5 Wrought iron 8 Concrete tile	CASING JOINTS: Glued <input checked="" type="checkbox"/> Clamped
1 Steel 3 RMP (SR)	6 Asbestos-Cement 9 Other (Specify below)	Welded
2 PVC 4 ABS	7 Fiberglass <b>SDR-26</b>	Threaded
Blank casing Diameter <b>5</b> in. to <b>24</b> ft., Dia in. to ft., Dia in. to ft.	weight <b>2.35</b> lbs. / ft.	Wall thickness or gauge No. <b>.214</b>
Casing height above land surface <b>12</b> in.,		
TYPE OF SCREEN OR PERFORATION MATERIAL:	5 Fiberglass 8 RMP (SR)	10 Asbestos-cement 11 other (specify)
1 Steel 3 Stainless Steel	6 Concrete tile 9 ABS	12 None used (open hole)
2 Brass 4 Galvanized steel		
SCREEN OR PERFORATION OPENING ARE:	5 Gauzed wrapped 8 Saw cut 11 None (open hole)	
1 Continous slot 3 Mill slot	6 Wire wrapped 9 Drilled holes	
2 Louvered shutter 4 Key punched	7 Torch cut 10 Other (specify)	
SCREEN-PERFORATION INTERVALS: from <b>24</b> ft. to <b>80</b> ft., From ft. to ft.		
GRAVEL PACK INTERVALS: from <b>24</b> ft. to <b>80</b> ft., From ft. to ft.		

6 GROUT MATERIAL: 1 Neat cement	2 Cement grout	3 Bentonite	4 Other
Grout Intervals: From <b>4</b> ft. to <b>24</b> ft. From ft. to ft.			
What is the nearest source of possible contamination:	10 Livestock pens 14 Abandon water well		
1 Septic tank 4 Lateral lines 7 Pit privy	11 Fuel storage 15 Oil well/Gas well		
2 Sewer lines 5 Cess pool 8 Sewage lagoon	12 Fertilizer storage 16 Other (specify below)		
3 Watertight sewer lines 6 Seepage pit 9 Feedyard	13 Insecticide storage <b>None Apparent</b>		
Direction from well?	How many feet?		

FROM	TO	LITHOLOGIC LOG	FROM	TO	PLUGGING INTERVALS
0	4	topsoil			
4	45	gray shale			
45	80	rock			

7 CONTRACTOR'S OR LANDOWNER'S CERTIFICATION: This water well was (1) constructed, (2) reconstructed, or (3) plugged under my jurisdiction and was completed on (mo/day/year) **08/10/1995** and this record is true to the best of my knowledge and belief. Kansas Water Well Contractor's License No. **236** This Water Well Record was completed on (mo/day/yr) **08/11/95**

Under the business name of **Harp Well & Pump Service, Inc** by (signature) *Jane Frederick*