


USE TYPEWRITER OR BALL POINT PEN-PRESS FIRMLY, PRINT CLEARLY.

WATER WELL RECORD
KSA 82a-1201-1215

Kansas Department of Health and Environment-Division of Environment (Water well Contractors) Topeka, Kansas 66620

1. Location of well: County Butler Fraction NE 1/4 NE 1/4 SE 1/4 Section number 26 Township number T 25 S R 3 E/W Range number

2. Distance and direction from nearest town or city: 2 1/2 mi E of Barta 4 mi N10
3. Owner of well: Herbert Lyber
R.R. or street: 1400 Farmstead Wichita
City, state, zip code:

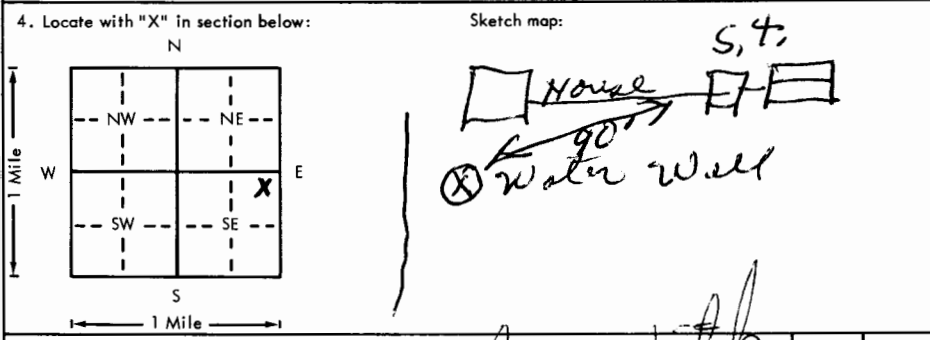

6. Bore hole dia. 10 in. Completion date 10-10-77
Well depth 82 ft. 10-11-77
7. Cable tool Rotary Driven Dig
 Hollow rod Jetted Bored Reverse rotary
8. Use: Domestic Public supply Industry
 Irrigation Air conditioning Stock
 Lawn Oil field water Other
9. Casing: Material PVC Height: Above or below
Threaded Welded Surface 21 in.

5. Type and color of material

	From	To
<u>Top Soil</u>	<u>0</u>	<u>3</u>
<u>Lime stone</u>	<u>3</u>	<u>18</u>
<u>Shale</u>	<u>18</u>	<u>28</u>
<u>Fine stone</u>	<u>28</u>	<u>31</u>
<u>Shale</u>	<u>31</u>	<u>98</u>
<u>Silt Brown</u>	<u>98</u>	<u>109</u>
<u>Gravel & silt</u>	<u>109</u>	<u>112</u>
<u>Shale</u>	<u>112</u>	<u>150</u>

Play Well

1 S.P.M.

10. Screens: Manufacturer's name M.P.T. 25/1000
Type P.V.C. Dia. 10
Slot/gauze 25/1000 Length 10
16. Nearest source of possible contamination: 5. ft.
ft. 90 Direction to Type S. T.
Well disinfected upon completion? Yes No
17. Pump: Not installed
Manufacturer's name _____
Model number _____ HP _____ Volts _____
Length of drop pipe _____ ft. capacity _____ g.p.m.
Type:
 Submersible Turbine
 Jet Reciprocating
 Centrifugal Other

18. Elevation: _____
19. Remarks: _____
20. Water well contractor's certification:
This well was drilled under my jurisdiction and this report is true to the best of my knowledge and belief.
Plant Const Co.
Business name Plant Const Co. License No. _____
Address Box 744
Signed Plant Const Co. Date 10-10-77
Authorized representative

25 - 30 26 NE NE SE
T R W Sec 1/4 1/4 1/4