


USE TYPEWRITER OR BALL POINT PEN-PRESS FIRMLY, PRINT CLEARLY.

WATER WELL RECORD
KSA 82a-1201-1215

Kansas Department of Health and Environment-Division of Environment (Water well Contractors) Topeka, Kansas 66620

1. Location of well: County Butler Fraction NE 1/4 NE 1/4 E 1/4 Section number 26 Township number T 25 S Range number R 3 E/W

2. Distance and direction from nearest town or city: 3 mi E. of Astoria 4 mi NO. 3. Owner of well: Robert Lyber R.R. or street: 1402 Hamilton St. City, state, zip code: Wichita KS 67202

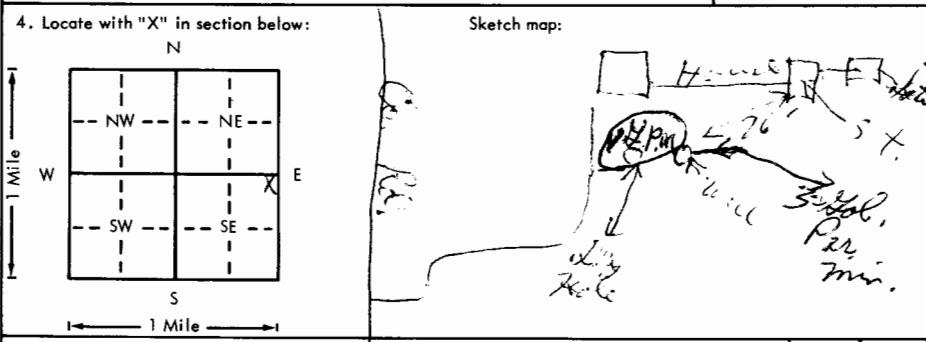

6. Bore hole dia. 10 in. Completion date 10-8-71 Well depth 86 ft.

7. Cable tool Rotary Driven Dug Hollow rod Jetted Bored Reverse rotary

8. Use: Domestic Public supply Industry Irrigation Air conditioning Stack Lawn Oil field water Other

9. Casing: Material None Height: Above or below None Threaded Welded Surface None in. RMP None PVC None Weight None lbs./ft. Dia. None in. to None ft. depth Wall Thickness: inches or Dia. None in. to None ft. depth gage No. None

5. Type and color of material	From	To
<u>Top soil</u>	<u>0</u>	<u>4</u>
<u>Limestone - white</u>	<u>4</u>	<u>21</u>
<u>Shale - gray</u>	<u>21</u>	<u>25</u>
<u>Limestone - white-gray</u>	<u>25</u>	<u>37</u>
<u>Shale - gray</u>	<u>37</u>	<u>70</u>
<u>Blue lime</u>	<u>70</u>	<u>86</u>

Handwritten notes:
P Plug
With 9 sacks
With neat cement for
25' the Red Clay to top
3 G.P.M.

10. Screen: Manufacturer's name _____ Type None Dia. _____ Slot/gauze None Length _____ Set between _____ ft. and _____ ft. _____ ft. and _____ ft. Gravel pack? _____ Size range of material _____

11. Static water level: _____ mo./day/yr. _____ ft. below land surface Date _____

12. Pumping level below land surfaces: _____ ft. after _____ hrs. pumping _____ g.p.m. _____ ft. after _____ hrs. pumping _____ g.p.m. Estimated maximum yield _____ g.p.m.

13. Water sample submitted: _____ mo./day/yr. Yes _____ No _____ Date _____

14. Well head completion: _____ Pitless adapter _____ inches above grade

15. Well grouted? _____ With: _____ Neat cement _____ Bentonite _____ Concrete Depth: From _____ ft. to _____ ft.

16. Nearest source of possible contamination: ft. 76 Direction SE Type Septic Well disinfected upon completion? Yes _____ No _____

17. Pump: _____ Not installed Manufacturer's name _____ Model number _____ HP _____ Volts _____ Length of drop pipe _____ ft. capacity _____ g.p.m. Type: _____ Submersible _____ Turbine _____ Jet _____ Reciprocating _____ Centrifugal _____ Other _____

18. Elevation: _____ 19. Remarks: _____

Topography: Hill Slope Upland Valley

20. Water well contractor's certification: This well was drilled under my jurisdiction and this report is true to the best of my knowledge and belief.

Paul Cant
Business name Box 9114 License No. _____
Address _____
Signed Paul Cant Date 10-8-71
Authorized representative