


USE TYPEWRITER OR BALL POINT PEN-PRESS FIRMLY, PRINT CLEARLY.

WATER WELL RECORD
KSA 82a-1201-1215

Kansas Department of Health and Environment-Division of Environment (Water well Contractors) Topeka, Kansas 66620

1. Location of well: County **BUTLER** Fraction **SW 1/4 SW 1/4 SW 1/4** Section number **31** Township number **T 25 S R 3** Range number **3**

2. Distance and direction from nearest town or city: **1 1/2 mi. W**
Street address of well location if in city: **2 no. of Benton**
3. Owner of well: **EARL SCHROEDER**
R.R. or street: **Rt 1**
City, state, zip code: **Benton, Ks. 67017**

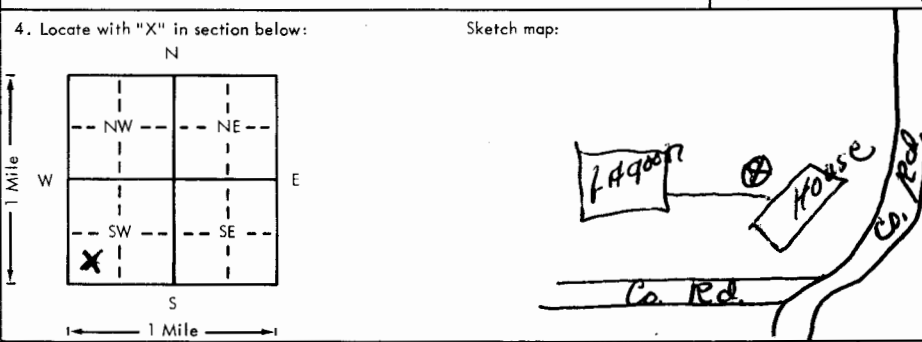

6. Bore hole dia. **10 7/8** in. Completion date **6-16-78**
Well depth **76** ft.

7. Cable tool Rotary Driven Dug
 Hollow rod Jetted Bored Reverse rotary

8. Use: Domestic Public supply Industry
 Irrigation Air conditioning Stock
 Lawn Oil field water Other

9. Casing: Material **PVC** Height Above or below
Threaded Welded Surface **19** in.
RMP PVC **PL** Weight **19** lbs./ft.
Dia. **5** in. to **66** ft. depth Wall Thickness: inches or
Dia. in. to ft. depth gage No. **258**

5. Type and color of material

	From	To
Topsoil	0	2
Red CLAY	2	76
SHALE (GRAY)	76	76

10. Screen: Manufacturer's name **M.B.L.**
Type **PLC** Dia. **5**
Slot/gauze **25/100** Length **10**
Set between **66** ft. and **76** ft.
 ft. and ft.
Gravel pack? **YES** Size range of material **30**

11. Static water level: mo./day/yr.
17 ft. below land surface Date **6-16-78**

12. Pumping level below land surfaces:
 ft. after hrs. pumping g.p.m.
 ft. after hrs. pumping g.p.m.
Estimated maximum yield **20** g.p.m.

13. Water sample submitted: mo./day/yr.
 Yes No Date

14. Well head completion:
 Pitless adapter Inches above grade

15. Well grouted? **YES**
With: Neat cement Bentonite Concrete
Depth: From **2 1/2** ft. to **13** ft.

16. Nearest source of possible contamination:
ft. **60** Direction **W** Type **Lagoon**
Well disinfected upon completion? Yes No

17. Pump: Not installed
Manufacturer's name _____
Model number _____ HP _____ Volts _____
Length of drop pipe _____ ft. capacity _____ g.p.m.
Type:
 Submersible Turbine
 Jet Reciprocating
 Centrifugal Other

18. Elevation: _____
Topography: Hill Slope Upland Valley
19. Remarks: **Owner Well installed
Concrete Slab 4x4x4
E. R. Schroeder**

20. Water well contractor's certification:
This well was drilled under my jurisdiction and this report is true to the best of my knowledge and belief.
Dr. Curt Const. License No. **353**
Address **Box 744**
Signed **Arto C. Paul** Date **6-16-78**
Authorized representative

25-30-31 SUSTAINED